


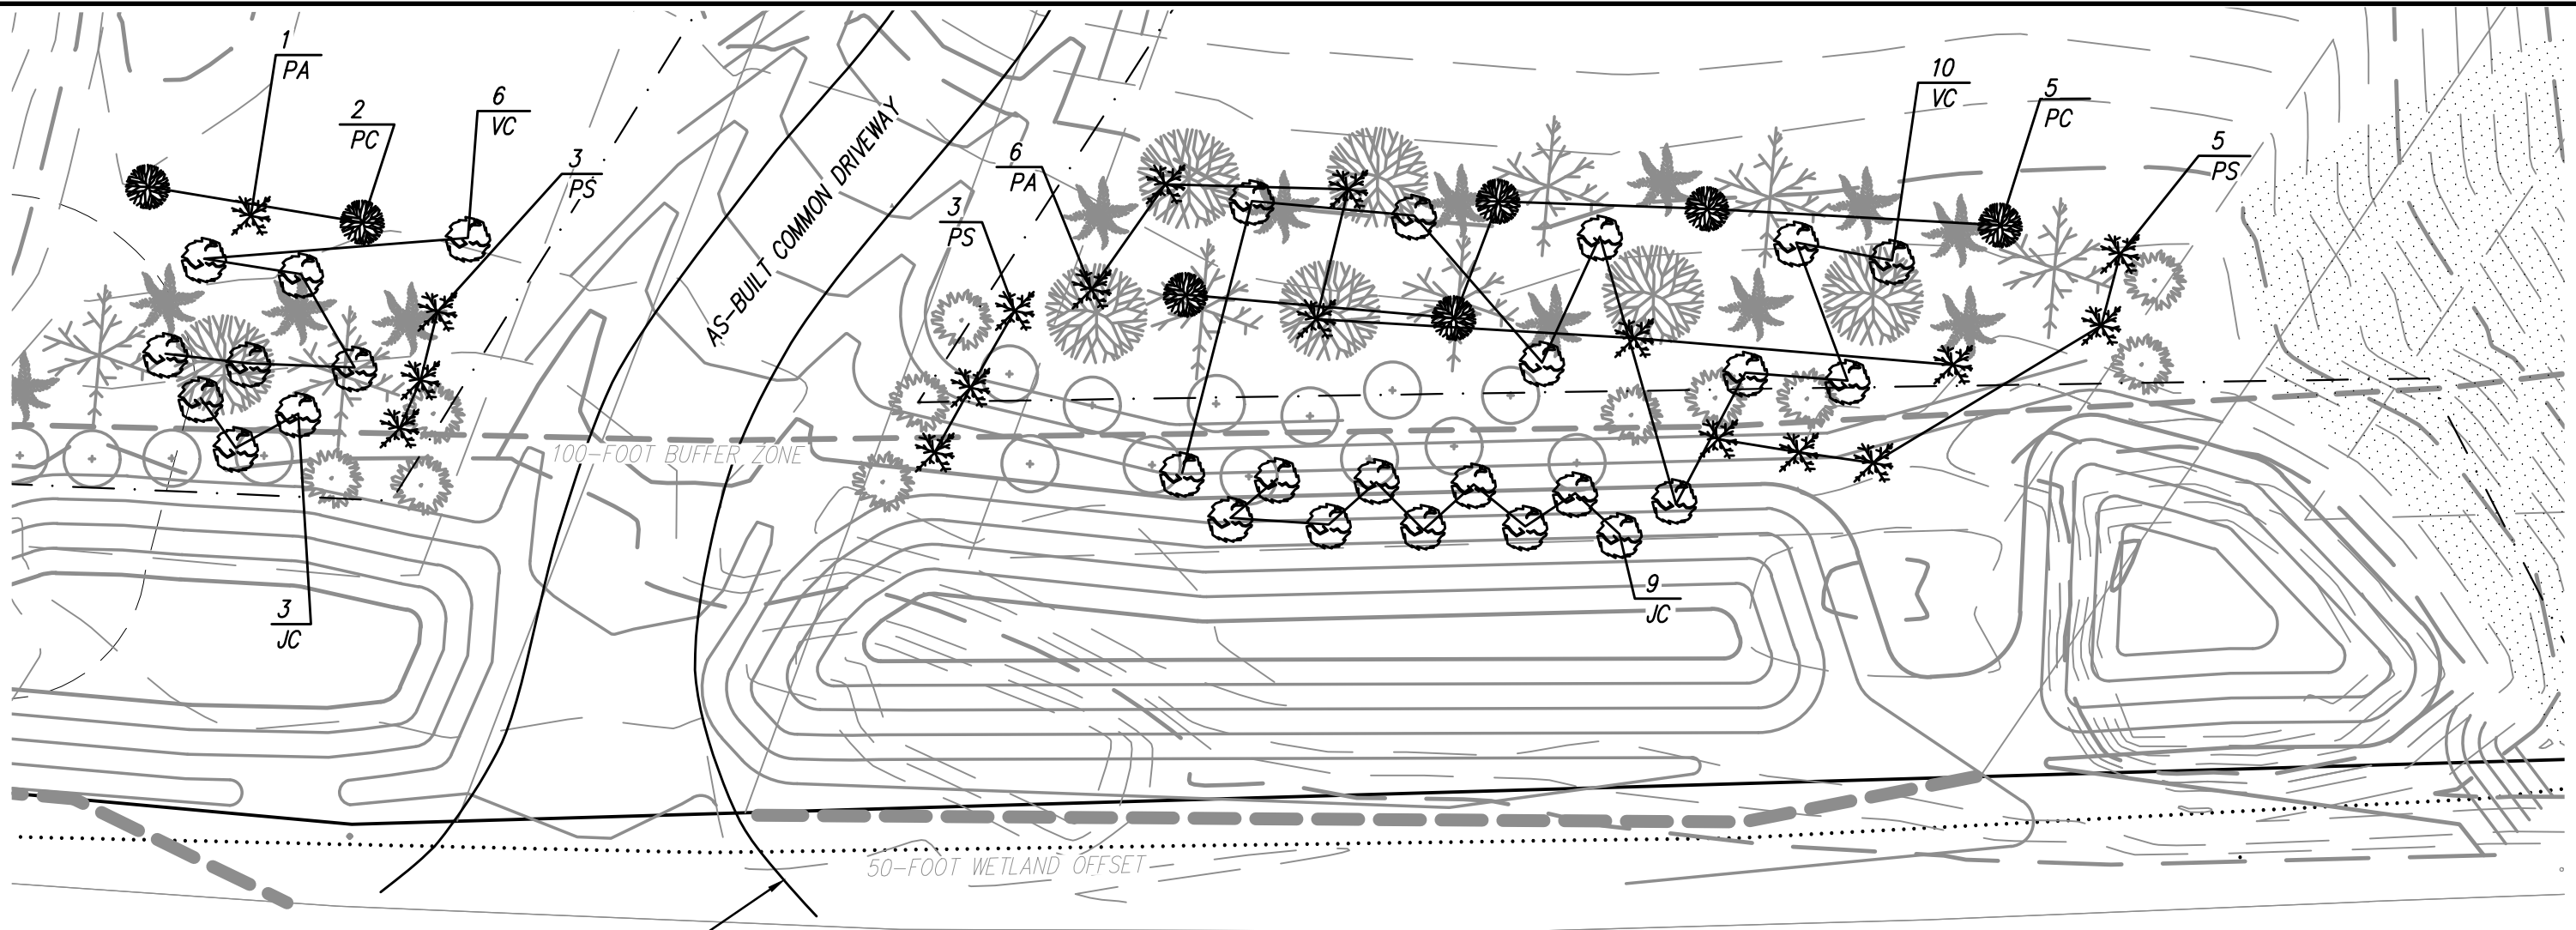

AS-BUILT PAVEMENT
(BASE COURSE ONLY)


AYER ROAD 1913 STATE HIGHWAY LAYOUT

AS-BUILT PLANTING SCHEDULE

SYMBOL:	BOTANICAL NAME:	COMMON NAME:	SIZE:	SPACING:	QUANTITY:
 PS	PINUS STROBUS	WHITE PINE	7' HIGH	AS SHOWN	11
 PA	PICEA ABIES	NORWAY SPRUCE	6' HIGH	AS SHOWN	7
 PC	PYRUS CALLERYANA	CHANTICLEAR PEAR	2" CALIPER	AS SHOWN	7
 VC	VIBURNUM CARLESII	SPICE GIRL VIBURNUM	#3 POT	AS SHOWN	16
 JC	JUNIPERUS CHINENSIS	SEA GREEN JUNIPER	#3 POT	AS SHOWN	12

NOTES:

- AS-BUILT PLANTINGS WERE LOCATED BY DILLIS & ROY CIVIL DESIGN GROUP IN NOVEMBER 2023.
- THE PROPOSED PROJECT IS SUBJECT TO THE CONDITIONS DETAILED IN THE ORDER OF CONDITIONS RECEIVED FROM THE LITTLETON CONSERVATION COMMISSION (RECORDED AT THE SOUTH MIDDLESEX REGISTRY OF DEEDS - BOOK 80925, PAGE 535).

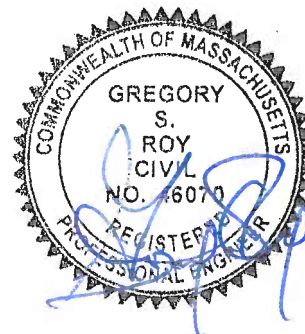

DILLIS & ROY
CIVIL DESIGN GROUP
CIVIL ENGINEERS LAND SURVEYORS WETLAND CONSULTANTS
CORPORATE OFFICE: 1 MAIN STREET, SUITE 1 LUNENBURG, MA 01462 978-779-6091 www.dillisoroy.com
CONCORD OFFICE: 100 MAIN ST., SUITE 310 CONCORD, MA 01742

PREPARED FOR:
BRIAN CARLSON
TRADITIONAL CONCEPTS, INC.
690 LANCASTER AVENUE
LUNENBURG, MA 01462

AS-BUILT PLANTING PLAN
9 AYER ROAD
LITTLETON, MA 01460

DESIGN BY: RWP	DRAWN BY: RWP	CHECKED BY: GSR	SHEET NO. 1 OF 1
DATE: 12/19/2023	JOB NUMBER: 6221-C	DRAWING NO. 6221-C-PLANT	1