


Revisions:		
No.	Date	Description
1	12/14/23	PER PEER REVIEW
2	01/23/24	CON COM REVIEW

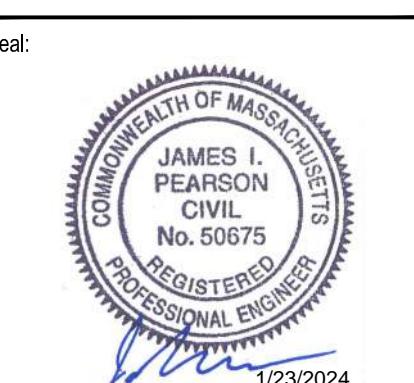



Issued For:
**PERMITTING - NOT
FOR
CONSTRUCTION**



Scale: AS NOTED

Date: OCTOBER 2023
Drawn By: GJK/RWS
Reviewed By: SBR
Approved By: TEM
W&S Project No.: ENG23-0679
W&S File No.:

Drawing Title:
**ACCESS ROAD
GRADING &
DRAINAGE PLAN**

Sheet Number:
C102

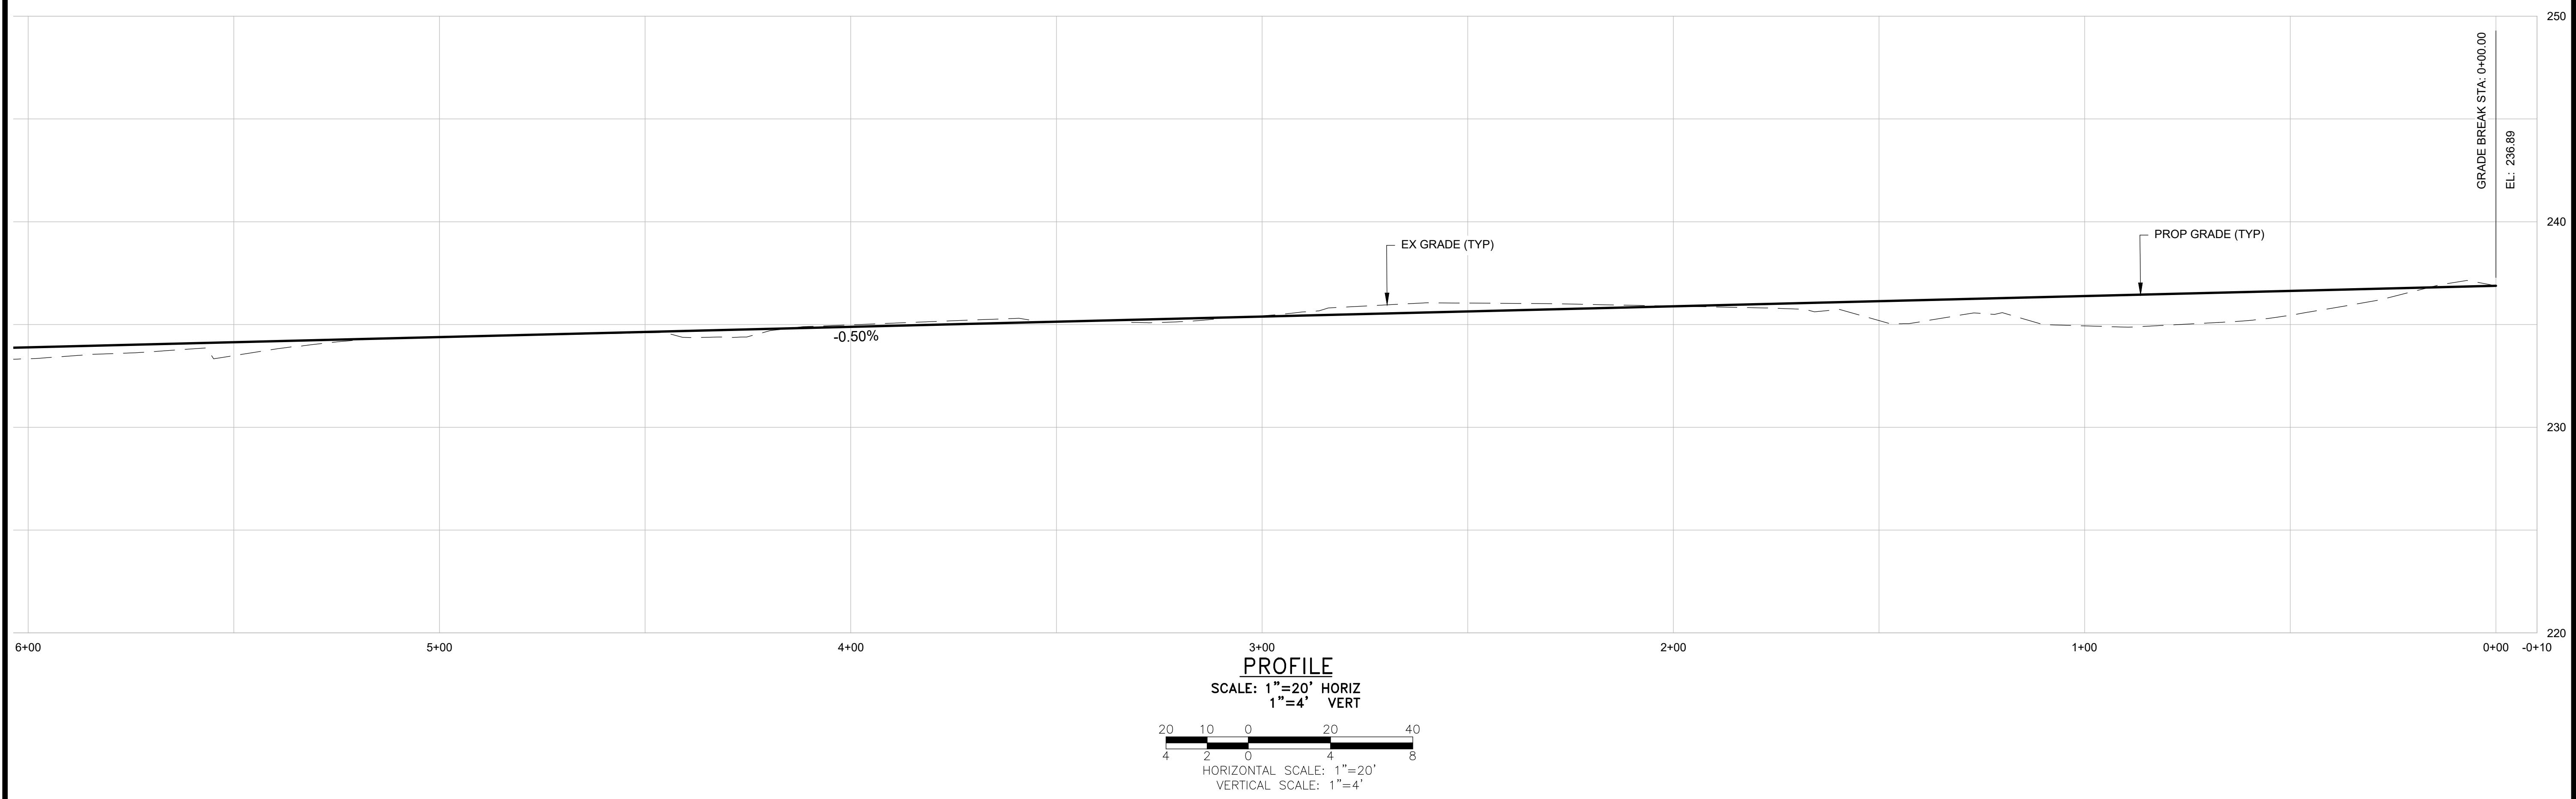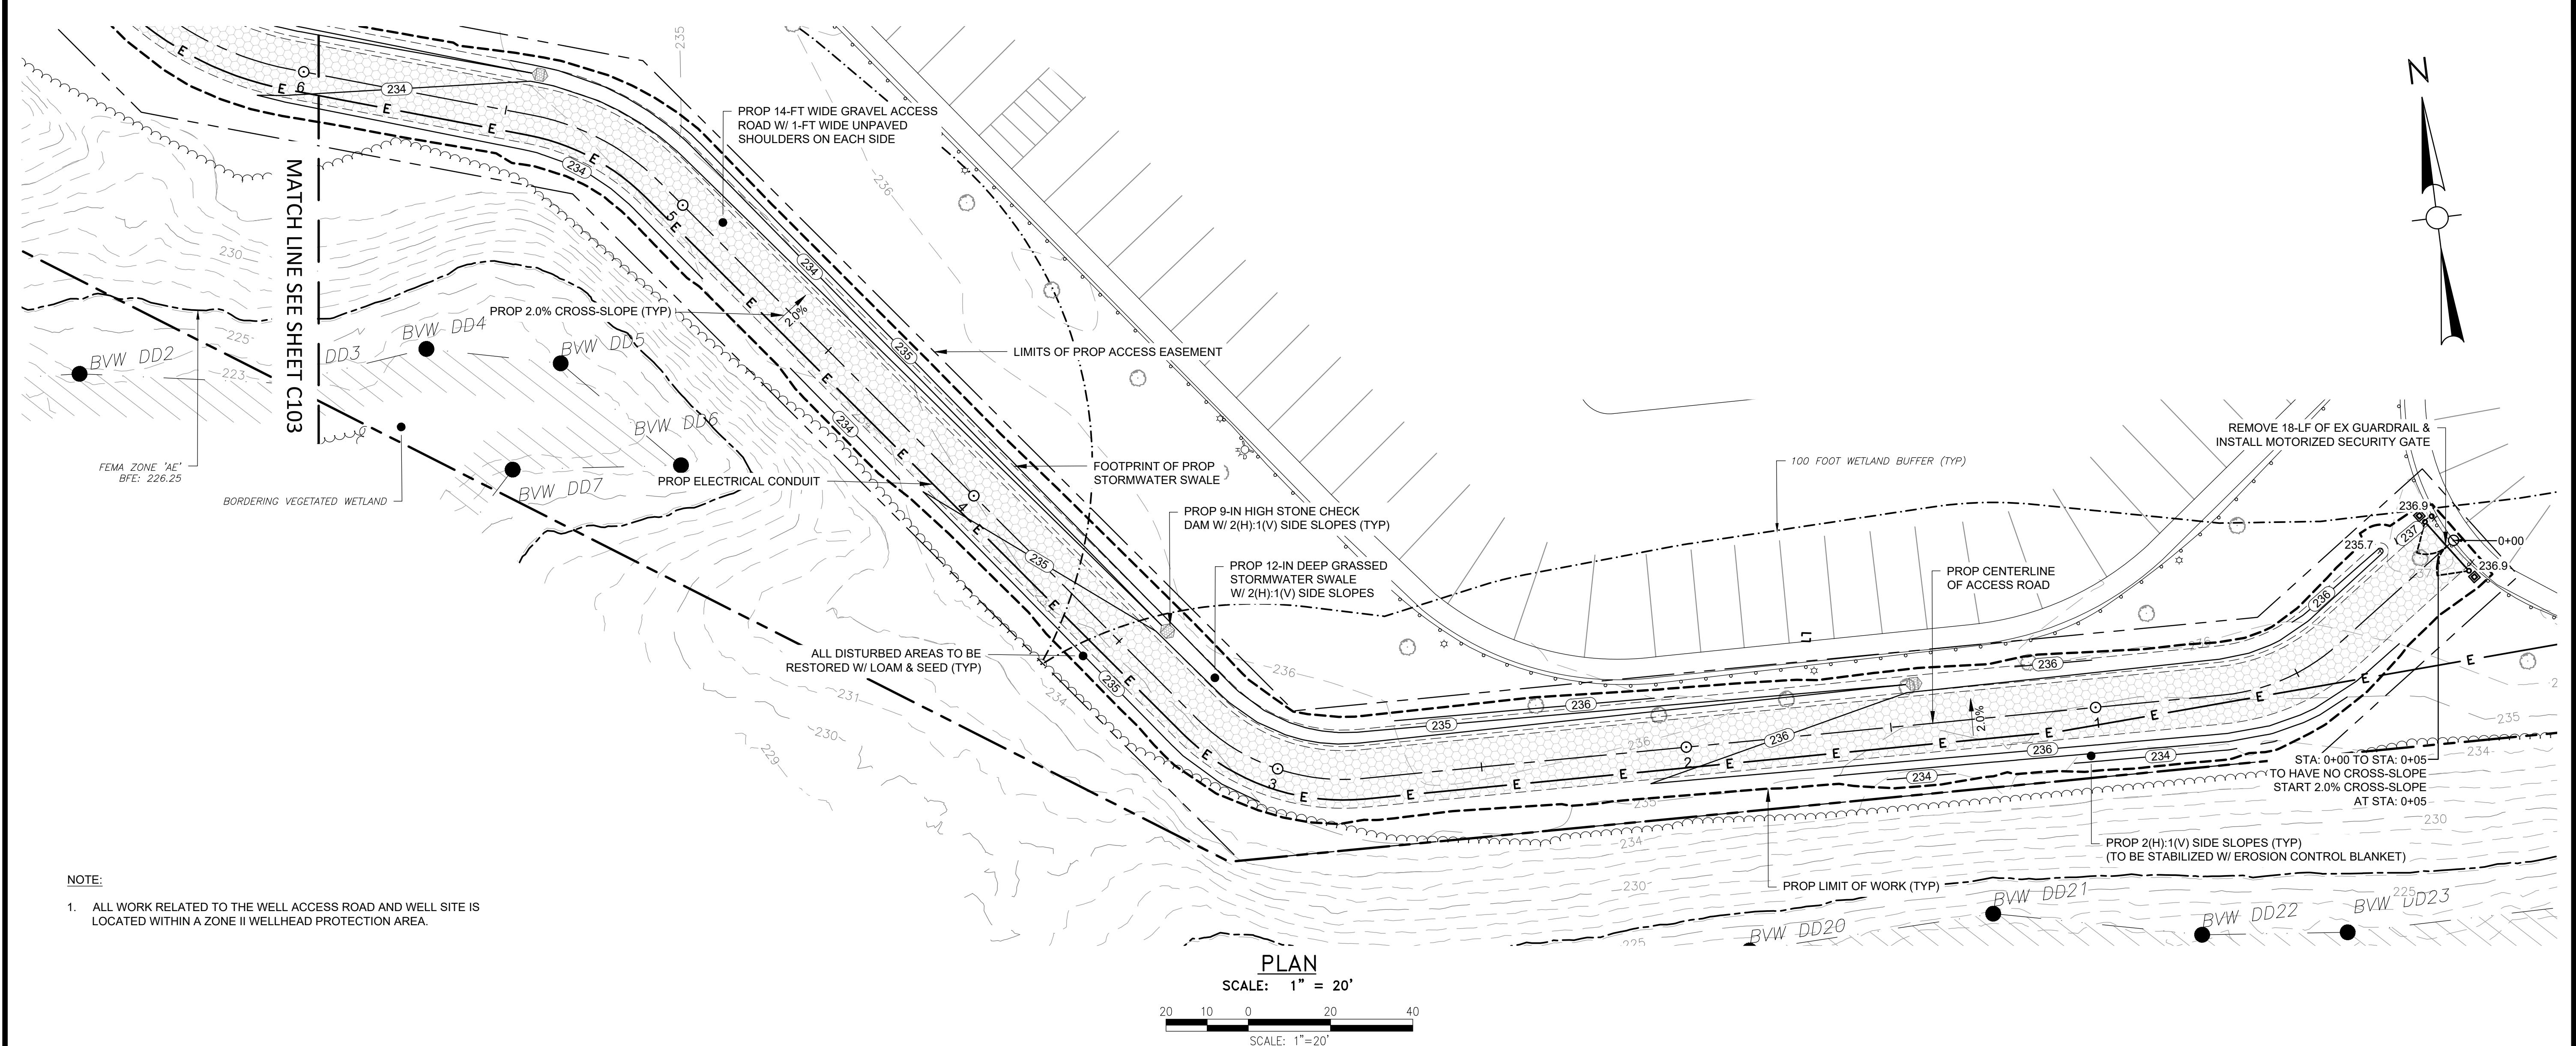

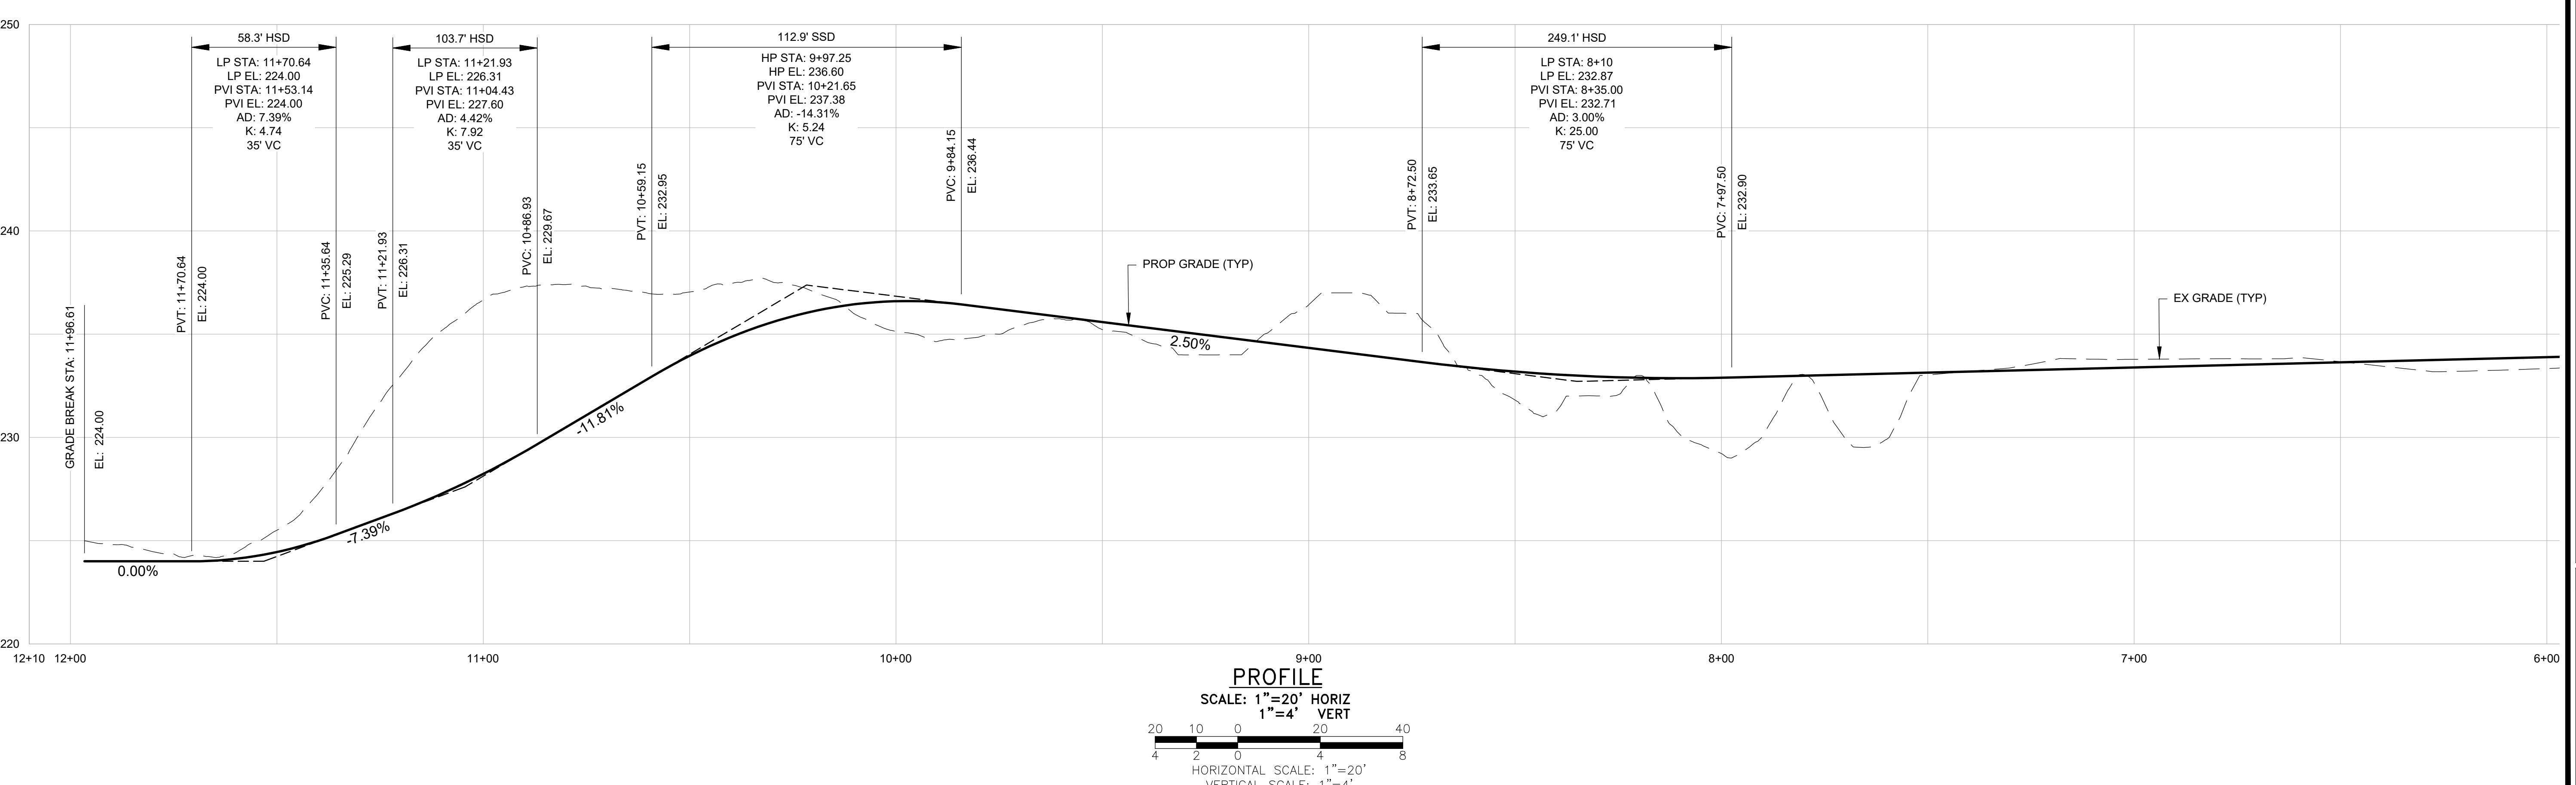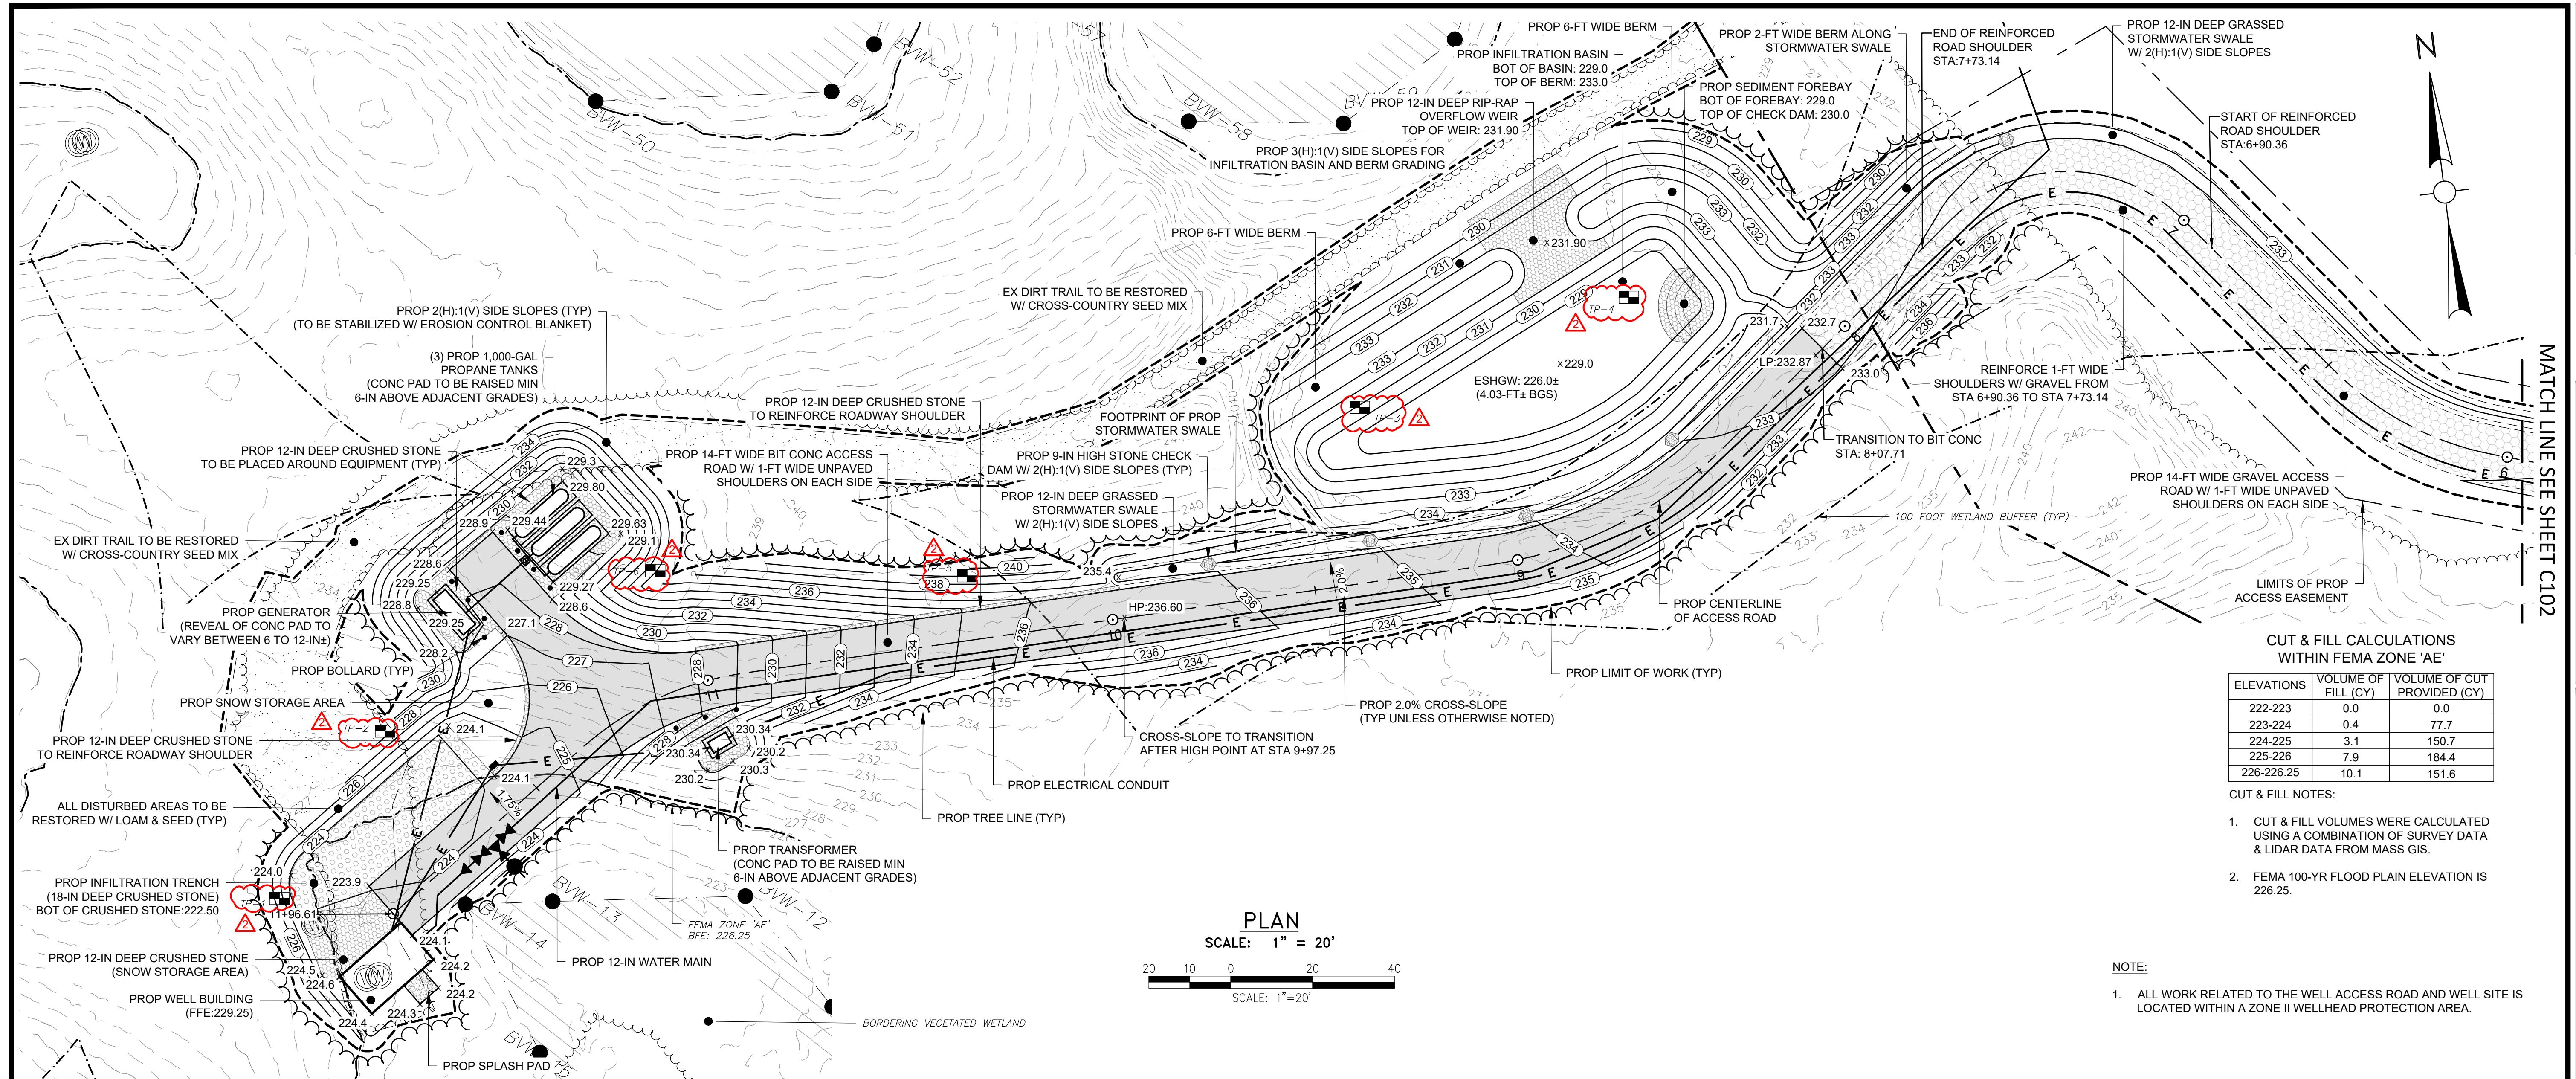

object:
TAYLOR STREET WELL

LITTLETON
ELWD
ELECTRIC LIGHT & WATER DEPARTMENTS

LITTLETON WATER
DEPARTMENT

39 AYER ROAD
LITTLETON, MA 01460
978-540-2222

The logo for Weston & Sampson. The word "Weston" is in blue, "Sampson" is in green, and the ampersand is also green. A blue circle surrounds the ampersand. A small "SM" is in the top right corner of the logo.

Consultants:

LEVELS	VOLUME OF FILL (CY)	VOLUME OF CUT PROVIDED (CY)
222-223	0.0	0.0
223-224	0.4	77.7
224-225	3.1	150.7
225-226	7.9	184.4
226-226.25	10.1	151.6

ST & FILL NOTES:

CUT & FILL VOLUMES WERE CALCULATED
USING A COMBINATION OF SURVEY DATA
& LIDAR DATA FROM MASS GIS.

FEMA 100-YR FLOOD PLAIN ELEVATION IS
226.25

A:

1/23/2024

ued For:
**PERMITTING - NOT
FOR
CONSTRUCTION**

ale: AS NOTED

te: OCTOBER 2023
awn By: GJK/RWS
viewed By: SBR
proved By: TEM
&S Project No.: ENG23-0679
2025 RELEASE UNDER E.O. 14176

awing Title:

WELL SITE AND ACCESS ROAD GRADING & DRAINAGE PLAN

Sheet Number: _____

Revisions:		
No.	Date	Description
1	12/14/23	PER PEER REVIEW
2	01/23/24	CON COM REVIEW


 Seal:
 COMMONWEALTH OF MASSACHUSETTS
 JAMES I.
 PEARSON CIVIL
 No. 50675
 REGISTERED
 PROFESSIONAL ENGINEER
 1/23/2024

Issued For:

PERMITTING - NOT
FOR
CONSTRUCTION

Scale:

AS NOTED

Date:

OCTOBER 2023

Drawn By:

GJK/RWS

Reviewed By:

SBR

Approved By:





TEM

W&S Project No.:

ENG23-0679

W&S File No.:

Drawing Title:

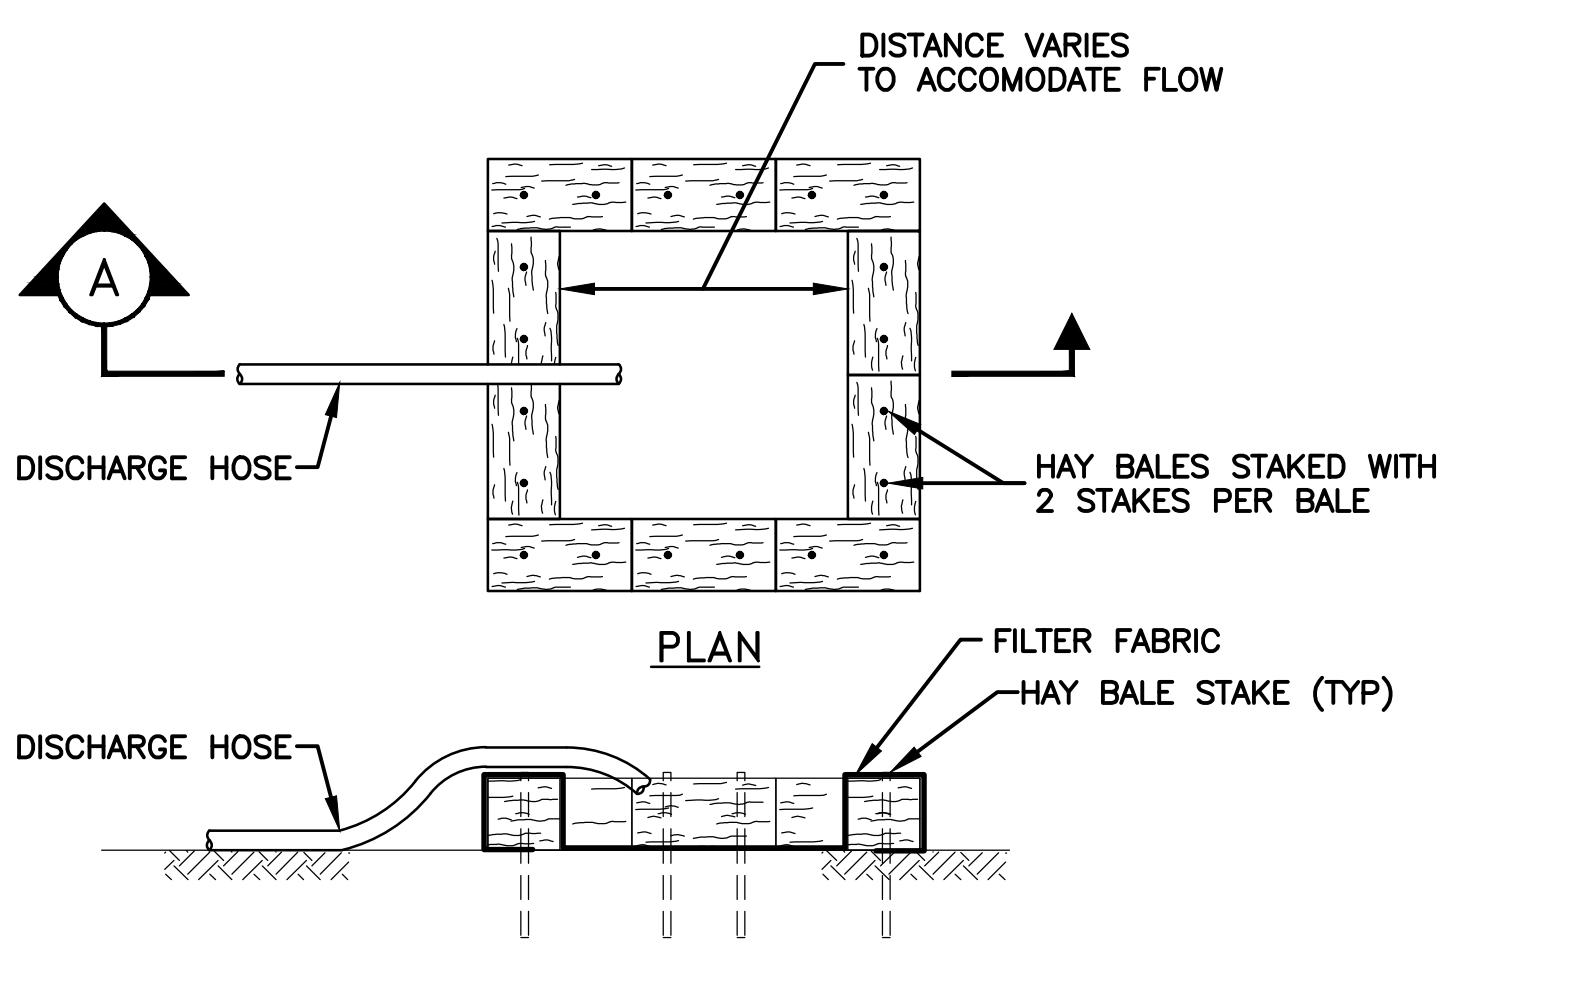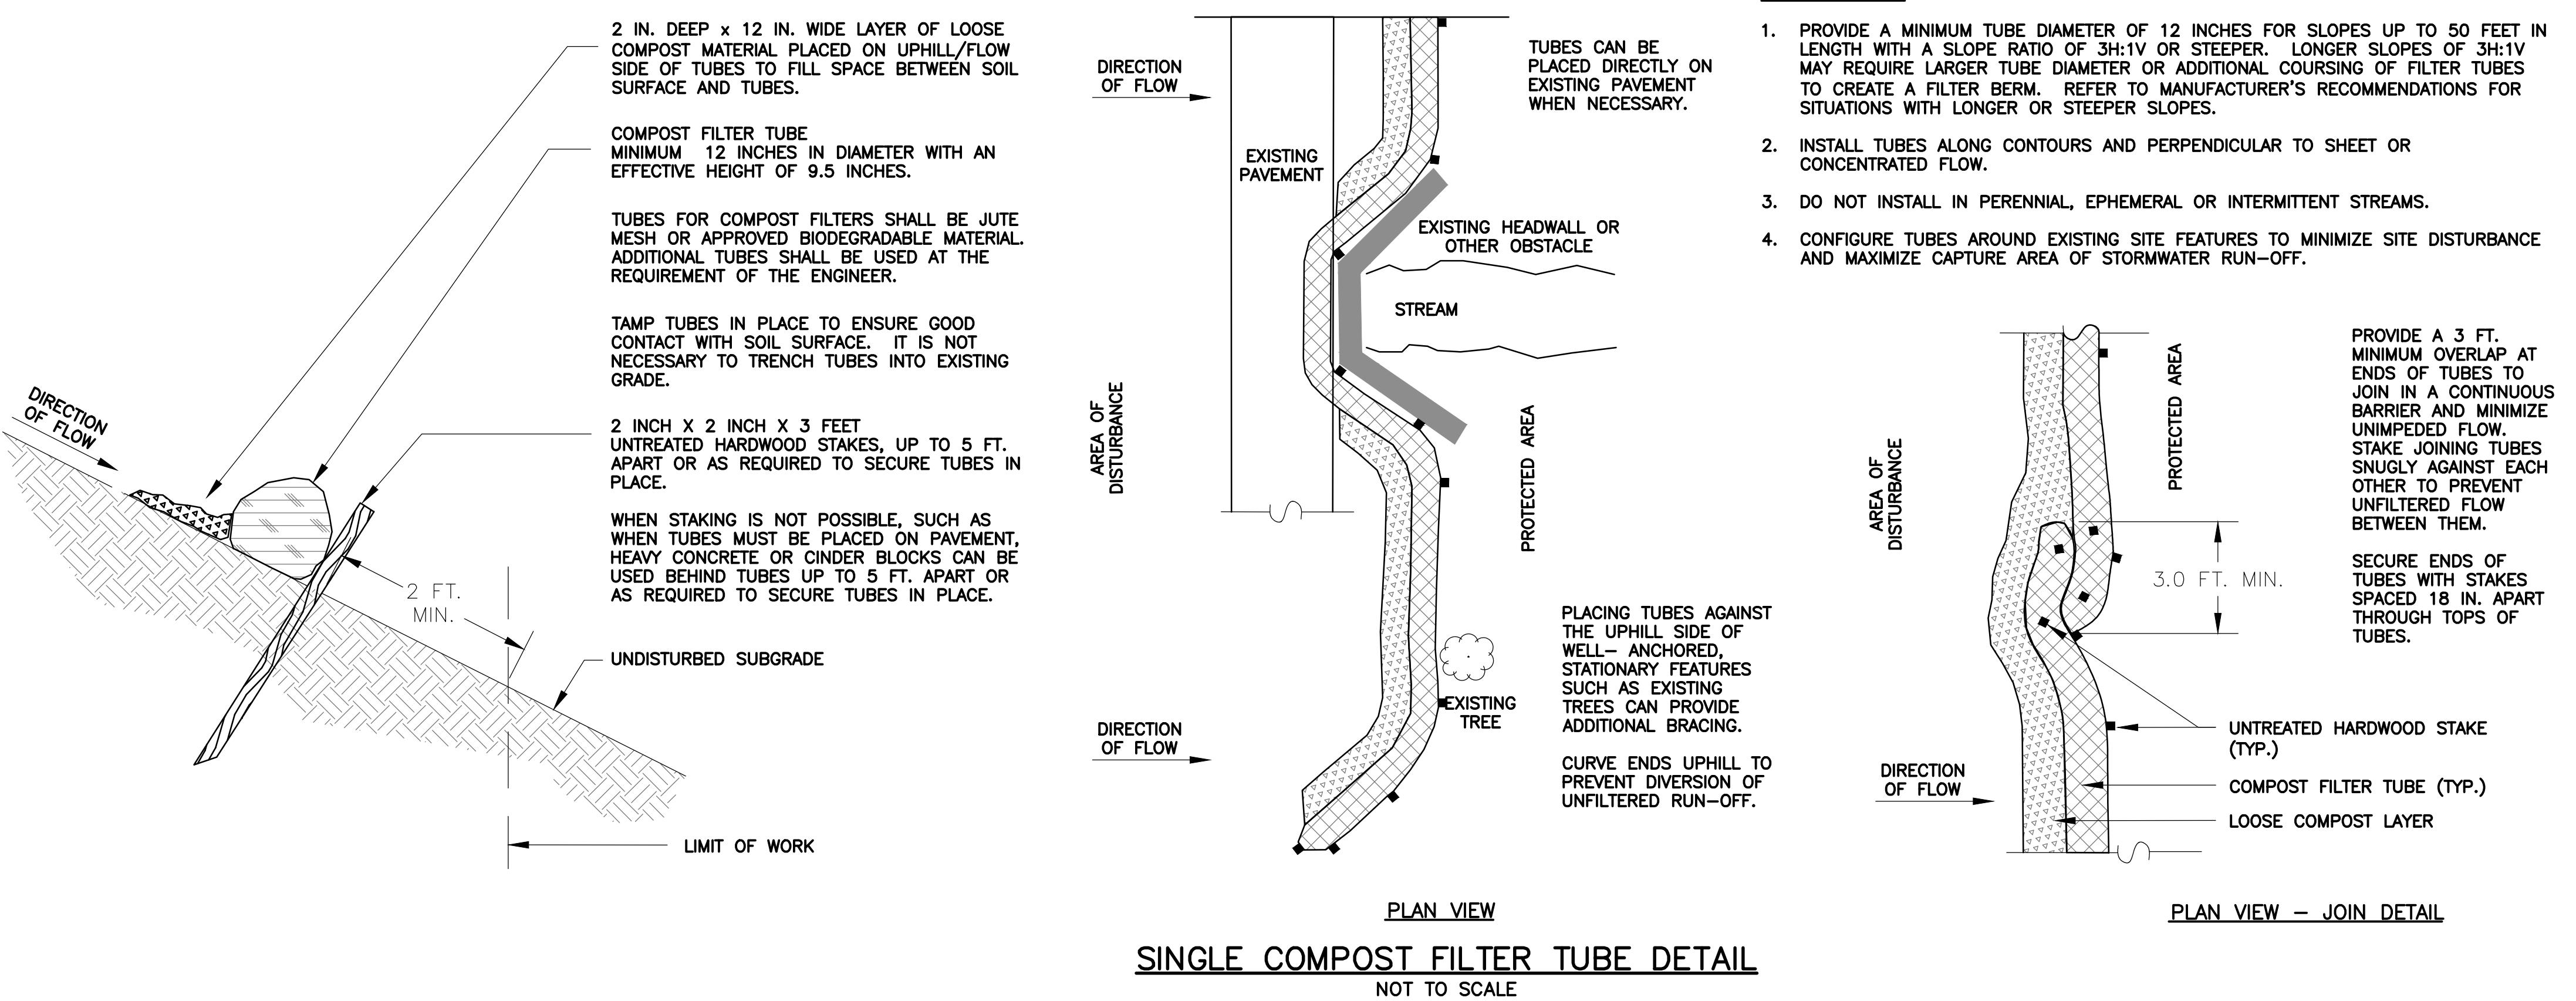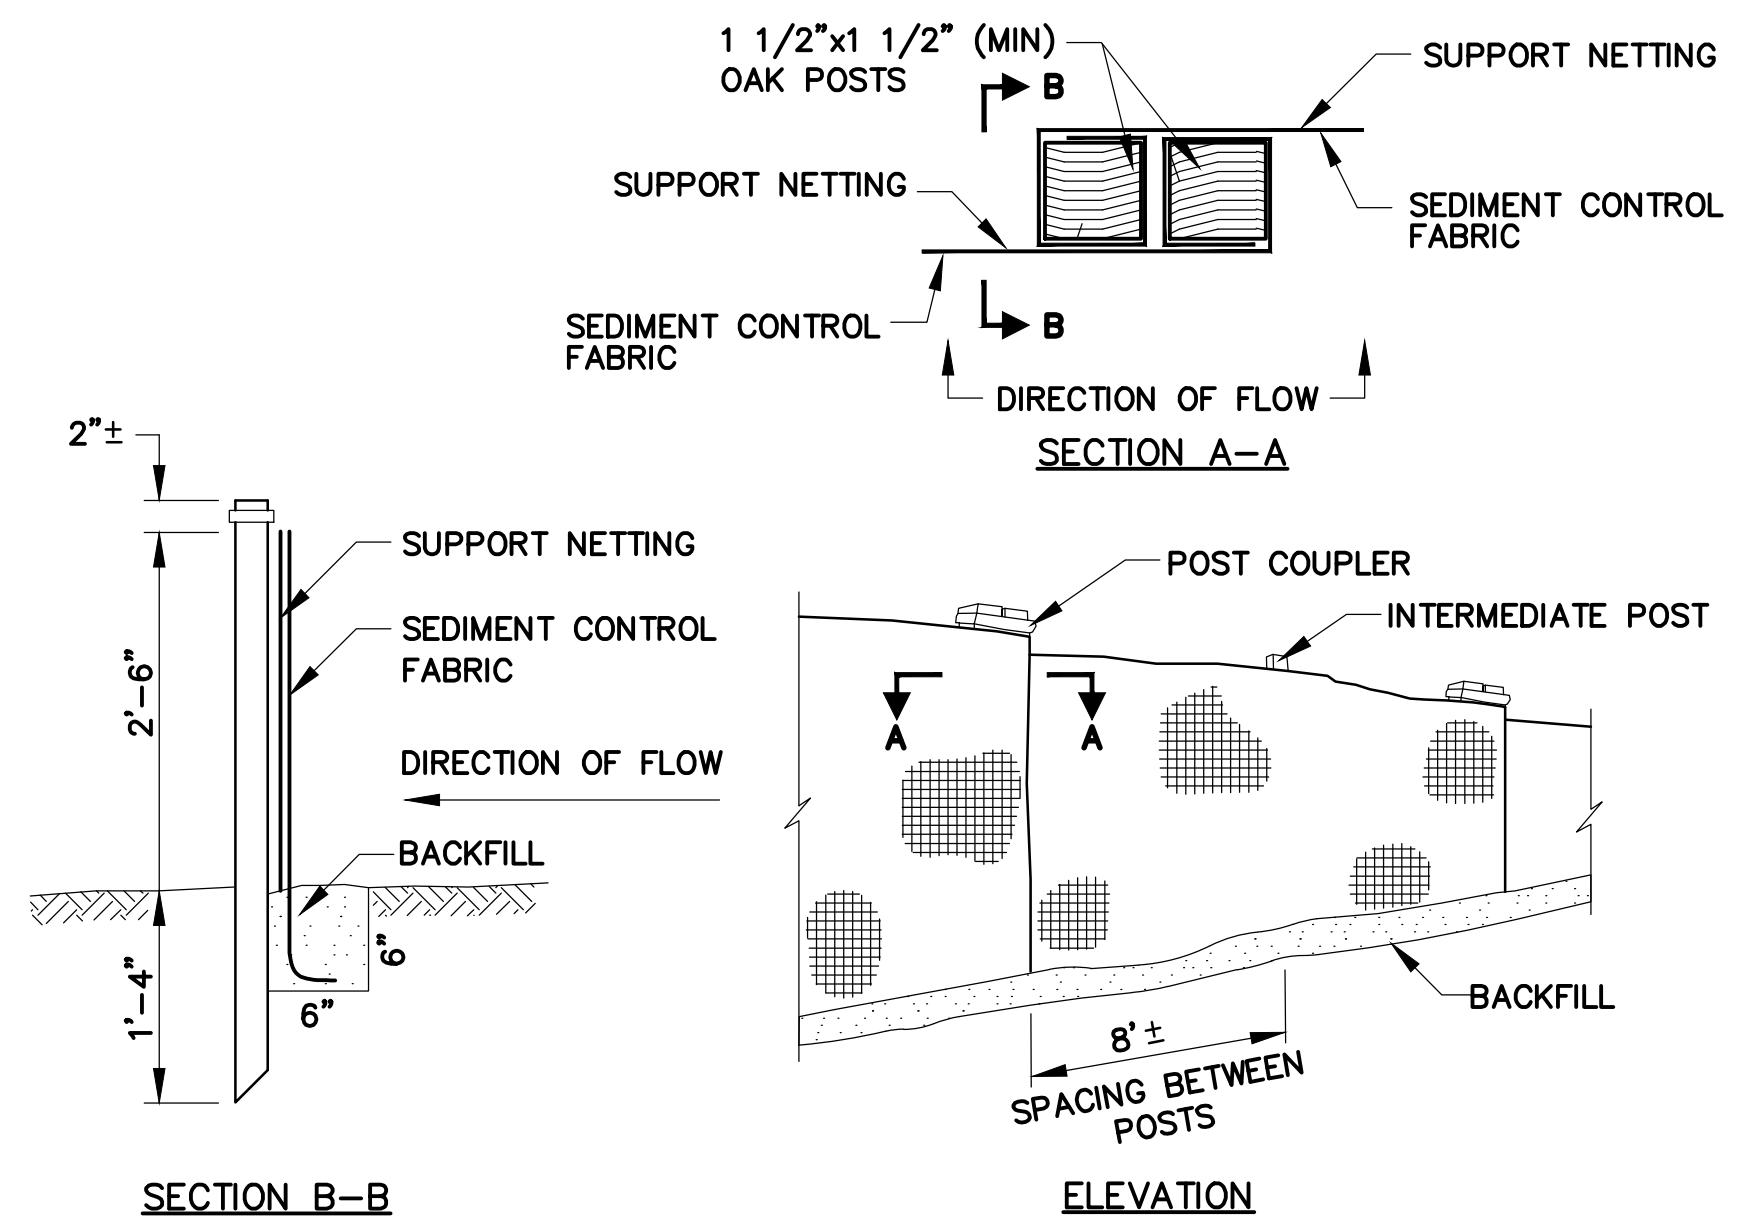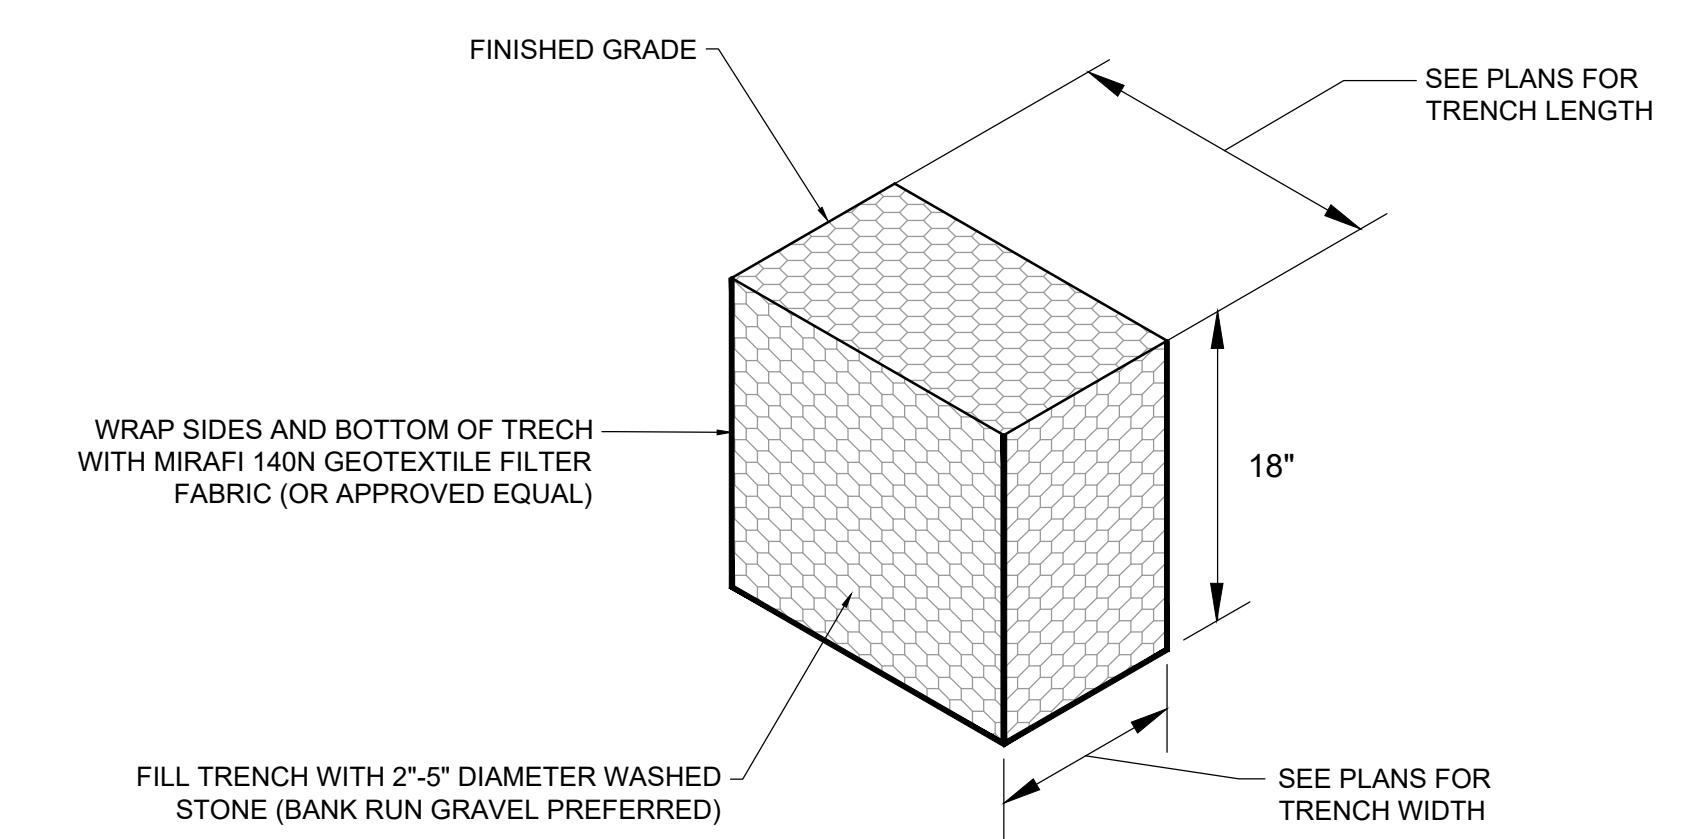CONSTRUCTION
DETAILS
DEWATERING DISCHARGE DISPOSAL DETAIL
 N.T.S.

SILT FENCE DETAIL
 N.T.S.

STORMWATER INFILTRATION TRENCH
 N.T.S.

