



SUBMITTAL REGISTRATION FORM

ONYX JOB #EX-24-0010

**MASSDOT 125644 - FOSTER STREET RECONSTRUCTION PROJECT
LITTLETON, MA**

Submittal Description: INVASIVE PLANT MANAGEMENT STRATEGY - FULL PLAN

Submittal No.: 102.33-003
Revision No.: 0

Spec Section: N/A
Sub Section:

SUBMITTAL DISTRIBUTION TYPE:

- Shop Drawing
- Working Drawings
- Schedule Submittal
- Miscellaneous Submittal

REVIEWER STAMP & COMMENTS

SUBMITTAL NOTES:

The above referenced submittal has been reviewed by the undersigned and I/we certify that the material and/or equipment meets or exceeds the project specification requirements with:

N/A No deviations

Deviations as noted below:

Print Name: _____

Signature: _____

Date: _____



Invasive Plant Management Strategy for Reconstruction of Foster Street in Littleton, Massachusetts

MassDOT Project No. 609054

MassDOT Contract No. 125644

PREPARED FOR

Massachusetts Department of Transportation

ON BEHALF OF

Onyx Corporation

PREPARED BY

SWCA Environmental Consultants

INVASIVE PLANT MANAGEMENT STRATEGY FOR RECONSTRUCTION OF FOSTER STREET IN LITTLETON, MASSACHUSETTS

Prepared for

Massachusetts Department of Transportation
10 Park Plaza, Suite 4160
Boston, Massachusetts 02116

On Behalf of

Onyx Corporation
18 Wetherbee Street
Acton, Massachusetts 01720

Prepared by

SWCA Environmental Consultants
15 Research Drive
Amherst, Massachusetts 01002
(413) 256-0202
www.swca.com

SWCA Project No. 0089854-000-AMH

CONTENTS

1	Introduction	1
1.1	Permit Compliance	1
2	Documentation of Invasive Plants on Site	1
3	Methods of Invasive Plant Management	2
3.1	Initial Management.....	3
3.1.1	Mechanical Management: Clearing and Excavating	3
3.1.2	Chemical Management: Herbicide Application.....	4
3.2	Follow-Up Management.....	5
4	Summary	5

Appendices

Appendix A. Invasive Plant Locations Map
Appendix B. Photographs
Appendix C. MassDOT Herbicide Use Report Form

Tables

Table 1. Invasive Plant Species Management Details	2
Table 2. Invasive Plant Management Timeline.....	5

1 INTRODUCTION

This Invasive Plant Management Strategy (IPMS) has been developed to provide the site contractor, Onyx Corporation, with specifications regarding the removal, handling, and management of invasive plants existing within the construction limits of the Reconstruction of Foster Street project (project site) in Littleton, Massachusetts. Invasive plant management is conducted on construction projects such as this one to improve the habitat value of the project site, protect the proposed landscape and/or restoration plantings, and prevent the future spread of invasive species from documented locations into uninfested project work areas. In addition to measurements of spread prevention, this plan specifies an invasive plant management goal to reduce or eliminate the cover of invasive plants found on the project site.

The measure of success for invasive plant management on this project is 85% reduction in invasive plants from preconstruction to the end of the project. This invasive reduction goal is based solely on the invasive plant populations currently existing within the bounds of the project site, as documented in this plan. Invasive plant populations frequently extend outside the project site and make total eradication infeasible.

Project construction will commence upon approval of this plan and will extend through Fall 2026. Invasive plant management will be conducted annually until project completion.

1.1 Permit Compliance

A Stormwater Pollution Prevention Plan (SWPPP) and Order of Conditions (OOC) (MassDEP File No. #204-0991) has been issued for construction work within resource areas and within the 50-foot No Disturbance Area of the Littleton Wetlands Protection bylaw. Currently, the OOC requires that herbicides proposed to be used need to be disclosed to the Conservation Commission and properly specified in an Amended OOC.

Onyx Corporation will need to request an amendment to the OOC in Fall/Winter of 2024 to allow for herbicide use during the summer of 2025.

2 DOCUMENTATION OF INVASIVE PLANTS ON SITE

SWCA conducted a survey of invasive plants within the construction limits on August 30, 2024, accompanied by representatives from MassDOT and Onyx Corporation, to identify the preconstruction locations of invasive plants across the project site.

The locations of invasive plants observed during the August 30, 2024, site visit is annotated in the Invasive Plant Locations Plan (Appendix A). SWCA also took photographs of key invasive plant populations during the August 30, 2024 visit, which are included in the attached photograph pages (Appendix B).

The invasive plant species with the greatest coverage on the project site are Asiatic bittersweet (*Celastrus orbiculatus*) and Japanese knotweed (*Fallopia japonica*). While the invasives documented in Appendix A represent preconstruction conditions on the day of the site visit, there are many invasive populations existing directly outside of the construction limits. Therefore, it is possible that these species could spread into the project area once soil has been disturbed. All invasive plants observed on-site will be targeted during each management visit and notes of new invasive plant locations will be relayed to the site contractor.

3 METHODS OF INVASIVE PLANT MANAGEMENT

A combination of chemical and mechanical management will take place for all invasive plants located within the project site. Mechanical clearing will need to be the first method of invasive management in order to keep construction activities on schedule. While several invasive plants will be managed, Japanese knotweed is of highest concern during construction activities due to its ability to spread through rhizome fragmentation. Herbicide application will be a necessary method of invasive plant management throughout the construction timeframe (through Fall 2026). Particular care needs to be given when clearing vegetation and/or mobilizing through areas where Japanese knotweed exists. See Section 3.1.1 for more details on how to carefully handle and work through areas of Japanese knotweed.

Mechanical methods can effectively manage many of the invasive plants present. Such methods include clearing, grubbing, and other excavation activities which will all occur during this project. SWCA will work with the site contractor to most effectively utilize both mechanical and chemical means of invasive plant management to meet the goals of this project as well as the construction schedule.

All herbicide applications will be conducted as detailed in Table 1 and will be applied using low-volume backpack sprayers. Herbicide will be mixed with non-ionic surfactant and a marking dye. This will allow applicators to conduct selective herbicide application and remain aware of all plants treated, which eliminates unnecessary overspray.

Table 1. Invasive Plant Species Management Details

Common Name	Scientific Name	Treatment Protocol	Management Timing
Japanese knotweed	<i>Fallopia japonica</i>	Foliar treatment; glyphosate	Late August to mid-October
Asiatic bittersweet	<i>Celastrus orbiculatus</i>	Foliar treatment (small stems); triclopyr Cut stem (large stems); triclopyr or glyphosate	June to October
Multiflora rose	<i>Rosa multiflora</i>	Foliar treatment (small stems); triclopyr or glyphosate Cut stem (large stems); triclopyr or glyphosate	June to October
Garlic mustard	<i>Alliaria petiolata</i>	Mechanical removal (small populations); hand pulling Foliar treatment (large populations); glyphosate	April to June
Porcelain berry	<i>Ampelopsis brevipedunculata</i>	Foliar treatment; glyphosate or triclopyr	June to October
Burning bush	<i>Euonymus alatus</i>	Foliar treatment (small stems); triclopyr or glyphosate Cut stem (large stems); triclopyr or glyphosate	June to October
Bush honeysuckle	<i>Lonicera</i> sp.	Foliar treatment (small stems); triclopyr or glyphosate Cut stem (large stems); triclopyr or glyphosate	June to October
Common buckthorn	<i>Rhamnus cathartica</i>	Foliar treatment (small stems); triclopyr or glyphosate Cut stem (large stems); triclopyr or glyphosate	June to October
Glossy buckthorn	<i>Frangula alnus</i>	Foliar treatment (small stems); triclopyr or glyphosate Cut stem (large stems); triclopyr or glyphosate	June to October
Autumn olive	<i>Elaeagnus umbellata</i>	Foliar treatment (small stems); triclopyr or glyphosate Cut stem (large stems); triclopyr or glyphosate	June to October
Purple loosestrife	<i>Lythrum salicaria</i>	Mechanical removal (small populations); hand pulling Foliar treatment (large populations); glyphosate	June to August

Common Name	Scientific Name	Treatment Protocol	Management Timing
Norway maple	<i>Acer platanoides</i>	Foliar treatment (small stems); glyphosate or triclopyr Hack and squirt (large stems and trees); glyphosate or triclopyr	June to October
All other invasive plants*		Young woody and herbaceous: foliar; glyphosate Mature shrubs: cut-stem; glyphosate. Mature trees: hack and squirt or cut-stem; glyphosate. Herbaceous invasives: foliar; glyphosate	April to October

Note: These herbicides are recommended for use. Either equivalent herbicides or similar herbicides may be used upon approval.

Note: "Mature" is defined as stems 1 or more inches in diameter; "Young" is defined as stems less than 1 inch in diameter.

* Any invasive plants (as defined by MIPAG and DEP's Inland Wetland Replication Guidelines), regardless of their documentation in this IPMS, will be managed if observed within the management limits.

3.1 Initial Management

3.1.1 **Mechanical Management: Clearing and Excavating**

Invasive plant species must be cleared to avoid delaying construction. Much of the invasive vegetation will be initially managed through clearing. Clearing will be performed with a combination of excavators and land clearing equipment. Any equipment that is used to clear vegetation or excavate soil in an area that contains invasive plants will be cleaned prior to moving into uninfested areas of the project site or beyond. Equipment cleaning will be performed outside of wetland resource areas and their buffers and will be conducted prior to moving into uninfested areas.

When the Japanese knotweed is cleared, it must be cut above ground level without dislodging or affecting the roots of the plant. All cutting implements must be cleaned after cutting and prior to use in areas not containing Japanese knotweed. Failure to do this can result in spreading the Japanese knotweed population. Any Japanese knotweed cutting planned by Onyx Corporation must be communicated with SWCA to prevent an overlap with any planned foliar treatments.

If Japanese knotweed can be excavated, then all excavated material must be buried or stockpiled according to Section 3.1.1.2. Burial is preferred over stockpiling as it has the lowest risk of spreading Japanese knotweed; however, it is not feasible on all construction sites. Section 3.1.1.1 includes best practices for equipment cleaning. Appendix A includes the planned locations for temporary stockpile areas.

If invasive plant material cannot be buried or stockpiled on-site, then it can be sent to a facility and disposed of off-site. The contractor must make the facility aware that the disposal contains invasive plant species.

3.1.1.1 **EQUIPMENT CLEANING**

All equipment will be cleaned using brushes, water, or compressed air prior to leaving areas with existing populations of invasive plant species. Using a combination of brushes and other hand tools to loosen compacted soil is preferable to the other two options, as brushes and hand tools will minimize the dispersal of any propagules. Any equipment that is used for the movement or clearing of soil within invasive populations will be cleaned prior to leaving the invasive-infested area. Cleaning will be performed on the tracks and buckets of the machines that have potentially come in contact with invasive root/propagule material.

If hand tools are used in clearing, they should also be cleaned prior to use in non-infested work areas. Cleaning activities shall occur outside of areas with disturbed soils and away from any surface waters to avoid the spread of seed material downstream.

If perimeter erosion controls are not already in place around these invasive-infested areas, the site contractor shall install a single line of straw bales around the area in which invasive plant propagules are cleaned from equipment. This will be performed to reduce the potential spread of invasives from infested to uninfested areas, particularly when there is bare soil in either the uninfested or infested areas in question. Final project close-out operations will include disposal of these perimeter controls. As they may contain viable invasive propagules, the receiving facility will be informed of that possibility, and the perimeter controls will not be reused after disposal.

All equipment used for the transport of invasive plant and root material will be inspected and cleaned prior to use with non-invasive materials. The site contractor will assume any soil and plant material remaining on equipment is invasive prior to use in uninfested portions of the project site. No oversight will be needed to conduct this task, but the site contractor must ensure all equipment is clear of excess soil and plant material when moving from an area of invasive infestation to one not infested.

3.1.1.2 SOIL MOVEMENT, BURIAL, AND STOCKPILING

If burying Japanese knotweed on-site is possible, the plant material may only be buried at least 6 feet deep in locations that already contain Japanese knotweed. When moving potentially viable invasive propagules (both within or outside of the project site), all material will be secured in an enclosed structure (such as a dump truck bed) to avoid spread in transport.

All invasive infested soil that need to be stockpiled will be in the location marked on the attached plan (see Appendix A). The stockpile area will be surrounded by perimeter sediment and erosion controls to eliminate the displacement of any material during rain events. Should the stockpile area remain small, silt fence and straw bales will suffice for perimeter controls. However, should the stockpile area exceed a height of 5 feet, lined jersey barriers wrapped in a semi-permeable fabric will be installed to accommodate the larger volume of sediment that could mobilize during a large storm event. Should a secondary stockpile location be required, the site contractor will report the new location to MassDOT.

The invasive stockpile area(s) will be specifically inspected and treated during each herbicide application event. All soils in areas that have been treated, and that are subsequently scheduled for excavation, shall be considered suitable for reuse contingent on the Engineer's determination that no evidence of invasive plant propagation has been documented for a 6-month period prior to excavation. SWCA can provide recommendations to the Engineer if needed. Stockpile areas shall be exposed and/or overturned multiple times before this determination is made.

3.1.2 *Chemical Management: Herbicide Application*

Due to construction timing, herbicide application will not be conducted prior to the start of clearing and grubbing. Where construction activities occur prior to herbicide application in areas that contain Japanese knotweed, the site contractor will follow the cleaning protocols outlined in Section 3.1.1.1. The other invasive plants on the project site will initially be well-managed through mechanical means, and all invasive plants will be re-treated with herbicide as needed in future management events (see Section 3.2).

3.2 Follow-Up Management

Additional management efforts are required to limit the spread of Japanese knotweed and other invasive plants on the project site following clearing and grubbing activities. All invasive plants will be targeted during each management visit regardless of being mapped in the preconstruction visit. Any new invasive plant locations found will be relayed to the site contractor.

Follow-up management will be conducted at least once during each year via a combination of herbicide application and mechanical removal. The proposed management schedule is included in Table 2. Any cutting to take place will be conducted with hedge trimmers, chain saws, or small hand tools (pruners, loppers, etc.) and will be performed in concert with herbicide application. Herbicide applications will be performed as indicated in Table 1. These management methods and timings have been included based on the ideal window for each invasive plant occurring on the project site. This timing is related to the flowering period for most invasive plants. The ideal timing for management is at or just after peak flowering. Any follow-up management to occur within the same growing season will occur a minimum of 2 to 3 weeks following any previous treatment.

As stated in Table 1, herbicide application may be conducted via foliar or cut-stem application. Foliar herbicide application will be performed by low-volume backpack sprayer. Cut-stem application will be conducted using Buckthorn Blasters®, a handheld applicator with a sponge tip. Where cut-stem applications are performed, cut material will be left in place. As construction activities will remove all large material prior to herbicide application, all cut-stem applications will be performed to small woody material, if needed. The exact implementation method (herbicide application or mechanical management) will be determined by SWCA in the field based on site conditions. All dead material will be left on-site where it falls to decompose naturally (as it ultimately would if it were not cut).

All herbicides that will be used for treatments are approved for use in wetlands and can be used in sensitive areas. Herbicide Use Reports will be submitted within 2 weeks of each application. A copy of the Herbicide Use Report form is included in Appendix C.

Table 2. Invasive Plant Management Timeline

Season	Task	Location
Fall 2024	Clearing and grubbing	Entire project site
	Establish stockpile	STA 35 to STA 38+75
August/September 2025	Initial herbicide application	Within construction limits
August/September 2026	Follow-up herbicide application	Within construction limits

* Fall is assumed to include September to October, spring is assumed to include the start of the growing season through mid-June, and summer is assumed to include mid-June through August. See Table 1 for species-specific management windows.

4 SUMMARY

SWCA will work closely with MassDOT and Onyx Corporation to manage invasive plants annually (or as needed) through the end of the construction period, which is planned to be Fall 2026. Initial methods of management include mechanical clearing, and follow-up methods include a combination of chemical and manual/mechanical management techniques. SWCA will conduct herbicide application to all invasive plants observed on-site during all follow-up management events, as detailed in Section 3 of this IPMS. SWCA will submit MassDOT Herbicide Use Reports within 2 weeks of any management event.

Full inspections will be conducted by SWCA during or immediately after the final management event of each year. Results of each inspection will determine the precise invasive plant management plan for the following year. However, the management methods outlined in this IPMS include the approved methods from which annual plans will be determined. A brief report will be submitted to Onyx Corporation and MassDOT upon request by the landscape architect, describing the state of invasive plant management and the precise plan for the upcoming management season. This report will include a marked-up figure (if requested) depicting the locations of invasive plant management and will detail the state of invasive plant presence in each treatment area. The goal for this invasive plant management plan is to reduce the cover of invasive plants within the construction limits of the project by 85% of their existing (preconstruction) footprint. General progress toward this goal will be reported in each annual summary report.

APPENDIX A

Invasive Plant Locations Map

STATE	FED. AID PROJ. NO.	HEET NO.	TOTAL SHEETS
MA	STP/CMQ/TAP-003(037)X	9	128

CONSTRUCTION PLANS

HIGHWAY GUARD DETAILS

NONE

TRAFFIC SIGNAL CONDUIT

NONE

WATER SUPPLY ALTERATIONS

SEE SHEET 57-64

DRAINAGE DETAILS

SEE SHEET NOS. 65-67

LEGEND:


PROPOSED PEDESTRIAN CURB RAMP DETAIL # X#

PROPOSED DRIVEWAY TYPE # DR#-#

NOTES:

1. ALL EXISTING GRANITE CURB WITHIN PROJECT LIMITS SHALL BE REMOVED & DISCARDED UNLESS OTHERWISE NOTED ON THE PLAN.
2. FOR GUARDRAIL DETAILS REFER TO STANDARD DETAILS 400.1.2, 400.1.3, 400.1.4, 400.1.5, 400.1.6, AND 400.5.1
3. ALL PROPOSED GRANITE CURB SHALL BE TYPE VB.
4. PRIOR TO CONSTRUCTION ACTIVITIES, A SITE WALK SHALL BE CONDUCTED WITH CONTRACTOR, ENGINEER, AND LANDSCAPE ARCHITECT TO DETERMINE SELECTIVE CLEARING AND THINNING OF TREES.
5. ALL PROPOSED CLEARING AND GRUBBING IS SHOWN WITH THE PROPOSED SLOPE LINE UNLESS OTHERWISE SHOWN.
6. LOCATIONS WHERE CLASS A ROCK EXCAVATION IS ENCOUNTERED NEAR GAS LINES, CONTRACTOR MUST ALSO PROVIDE VIBRATION MONITORING. (ITEM 757.)

High Density Japanese knotweed, not likely to be eradicated.

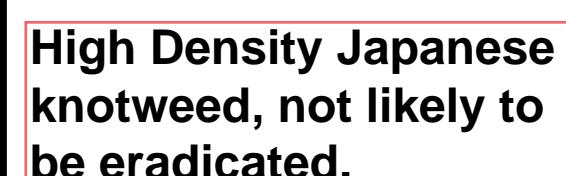

DANIEL SWEENEY (CLASS A TRUSTEE)
ARTURO J. GUTIERREZ, JOHN A.
CATALDO (CLASS B TRUSTEES)
TAYLOR STREET, LITTLETON TRUST
BK/PG 32096/213
PARCEL #R10 6 0
TAYLOR STREET

APPROX. SLOPE LIMIT
PROP. EDGE OF PVMT
BEGIN PROP. GRAN. CURB
(FLUSH TRANSITION AT BIKE RAMP)
PROP. 6' HMA BIKE RAMP
(PAID FOR UNDER ITEM 702.)
PROP. LOAM & SEED
PROP. CONC. BIKE RAMP
(DIRECTIONAL BAR TILE OPTION)
PROP. TEMP. EASEMENT
PROP. CEM. CONC. PCR
PROP. RECTANGULAR RAPID
FLASHING BEACON (RRFB)

PROP. CEM. CONC. PCR
END PROP. GRAN. CURB
BEGINNING OF PROJECT
PROJ. NO. 609054
STA 0+00.00
N3012786.8847
E653296.9381

STA 203+20.63 ALIGN_TAYLOR
STA 0+00.00 ALIGN_FOSTER
N 3012786.8847 E 653296.9381

PROP. TEMP. EASEMENT
PROP. PERM. UTL. EASEMENT
PROP. LIMIT OF CLEARING AND
GRUBBING BEHIND
SLOPE LIMIT
PROP. CEM. CONC. PCR

LIMIT OF PVMT MILL & OVERLAY
SAWCUT PVMT
MATCH EXISTING
RET. STONE WALL
WOODS

1959 SHLD NO. 1
NO. 1
N 3012786.8847 E 653296.9381
PROP. TEMP. EASEMENT
PROP. PERM. UTL. EASEMENT
PROP. LIMIT OF CLEARING AND
GRUBBING BEHIND
SLOPE LIMIT
PROP. CEM. CONC. PCR

LIMIT OF PVMT MILL & OVERLAY
SAWCUT PVMT
MATCH EXISTING
RET. STONE WALL
WOODS

TRAFFIC SIGNAL CONDUIT

NONE

WATER SUPPLY ALTERATIONS

SEE SHEET 57-64

DRAINAGE DETAILS

SEE SHEET NOS. 65-67

LEGEND:

PROPOSED PEDESTRIAN CURB RAMP DETAIL # X#

PROPOSED DRIVEWAY TYPE # DR#-#

NOTES:

1. ALL EXISTING GRANITE CURB WITHIN PROJECT LIMITS SHALL BE REMOVED & DISCARDED UNLESS OTHERWISE NOTED ON THE PLAN.
2. FOR GUARDRAIL DETAILS REFER TO STANDARD DETAILS 400.1.2, 400.1.3, 400.1.4, 400.1.5, 400.1.6, AND 400.5.1
3. ALL PROPOSED GRANITE CURB SHALL BE TYPE VB.
4. PRIOR TO CONSTRUCTION ACTIVITIES, A SITE WALK SHALL BE CONDUCTED WITH CONTRACTOR, ENGINEER, AND LANDSCAPE ARCHITECT TO DETERMINE SELECTIVE CLEARING AND THINNING OF TREES.
5. ALL PROPOSED CLEARING AND GRUBBING IS SHOWN WITH THE PROPOSED SLOPE LINE UNLESS OTHERWISE SHOWN.
6. LOCATIONS WHERE CLASS A ROCK EXCAVATION IS ENCOUNTERED NEAR GAS LINES, CONTRACTOR MUST ALSO PROVIDE VIBRATION MONITORING. (ITEM 757.)

Invasive Management limits are outlined in red.



PROP. LIMIT OF CLEARING AND GRUBBING BEHIND SLOPE LIMIT

PROP. CLASS A ROCK EXCAVATION IN ADVANCE
OF U.P. INSTALLATION (AS ENCOUNTERED)

OVERHEAD TREE TRIMMING 10' FROM PROP. OHW (TYP.)

PROP. PERM. UTL. EASEMENT

PROP. 10' SHARED-USE PATH

APPROX. SLOPE LIMIT

PROP. LOAM & SEED

R&R STONE WALL

PROP. TREE (SEE
LANDSCAPING PLAN) - TYP.PROP. PERM.
UTL. EASEMENT

PROP. TEMP. EASEMENT

REM. TREE

REM. TREE

PROP. CEM. CONC. WALK

REM. TREE

PROP. PERM. UTL. EASEMENT

REM. TREE

PROP. CEM. CONC. PCR

PROP. FULL DEPTH PVMT
RECONSTRUCTION

EDGE OF PAVEMENT

U/G TEL (D)

PROP. FULL DEPTH PVMT
RECONSTRUCTION

CONSTRUCTION & 3

4 PC +03.30

EDGE OF PAVEMENT

Woods

PROP. RAISED CONC. ISLAND

RET. MW

PROP. GRAN. CURB

RET. EXIST. WALL &
LANDSCAPE AREA

LIMIT OF PVMT RECONSTRUCTION

SAWCUT PVMT
MATCH EXISTING

PROP. TEMP. EASEMENT

BEGIN PROP. GRAN. CURB

END PROP. GRAN. CURB

BEGIN HMA BERM TYPE A MODIFIED

STA. 4+21

PROP. CEM. CONC. PCR

PROP. FULL DEPTH PVMT
RECONSTRUCTION

CONSTRUCTION & 3

4 PC +03.30

EDGE OF PAVEMENT

Woods

PROP. RAISED CONC. ISLAND

RET. MW

PROP. GRAN. CURB

RET. EXIST. WALL &
LANDSCAPE AREA

LIMIT OF PVMT RECONSTRUCTION

SAWCUT PVMT
MATCH EXISTING

PROP. TEMP. EASEMENT

BEGIN PROP. GRAN. CURB

END PROP. GRAN. CURB

PROP. CEM. CONC. PCR

LITTLETON
RECONSTRUCTION OF FOSTER STREET

STATE	FED. AID PROJ. NO.	SHEET NO.	TOTAL SHEETS
MA	STP/CMQ/TAP-0033(037)X	10	128
PROJECT FILE NO.		609054	

CONSTRUCTION PLANS

20170044A21_HPN01.DWG Plotted on 27-Mar-2024 9:59 AM

HIGHWAY GUARD DETAILS

<u>TRAFFIC SIGNAL CONDUIT</u>	<u>WATER SUPPLY ALTERATIONS</u>	<u>DRAINAGE DETAILS</u>
NONE	SEE SHEET 57-64	SEE SHEET NOS. 65-67

LEGEND:

PROPOSED PEDESTRIAN CURB RAMP DETAIL # X#

PROPOSED DRIVEWAY TYPE # DR#

LITTLETON RECONSTRUCTION OF FOSTER STREET

* Invasive population outside of temporary easement. Not to be treated

** Invasive population begins within easement but extends outside

Treatment will only occur within easement.

FOR PROFILE: SEE SHEET NO. 18

SCALE: 1" = 20'

Percent Cover of Invasives

Green: 0-5%

Yellow: 6-25%

Orange: 26-75%

Red: 76-100%

HIGHWAY GUARD DETAILS

STEEL W-BEAM GUARDRAIL (TL-2) W/ WOOD POST & TANGENT END STA. 9+46 LT
TO TANGENT END STA 10+84 LT

TRAFFIC SIGNAL CONDUIT

NONE

WATER SUPPLY ALTERATIONS

SEE SHEET 57-64

DRAINAGE DETAILS

SEE SHEET NOS. 65-67

LEGEND:

PROPOSED PEDESTRIAN CURB
RAMP DETAIL #


X#

PROPOSED DRIVEWAY
TYPE #

DR#

LITTLETON
RECONSTRUCTION OF FOSTER STREET

STATE	FED. AID PROJ. NO.	HEET NO.	TOTAL SHEETS
MA	STP/CMQ/TAP-0033(037)X	11	128

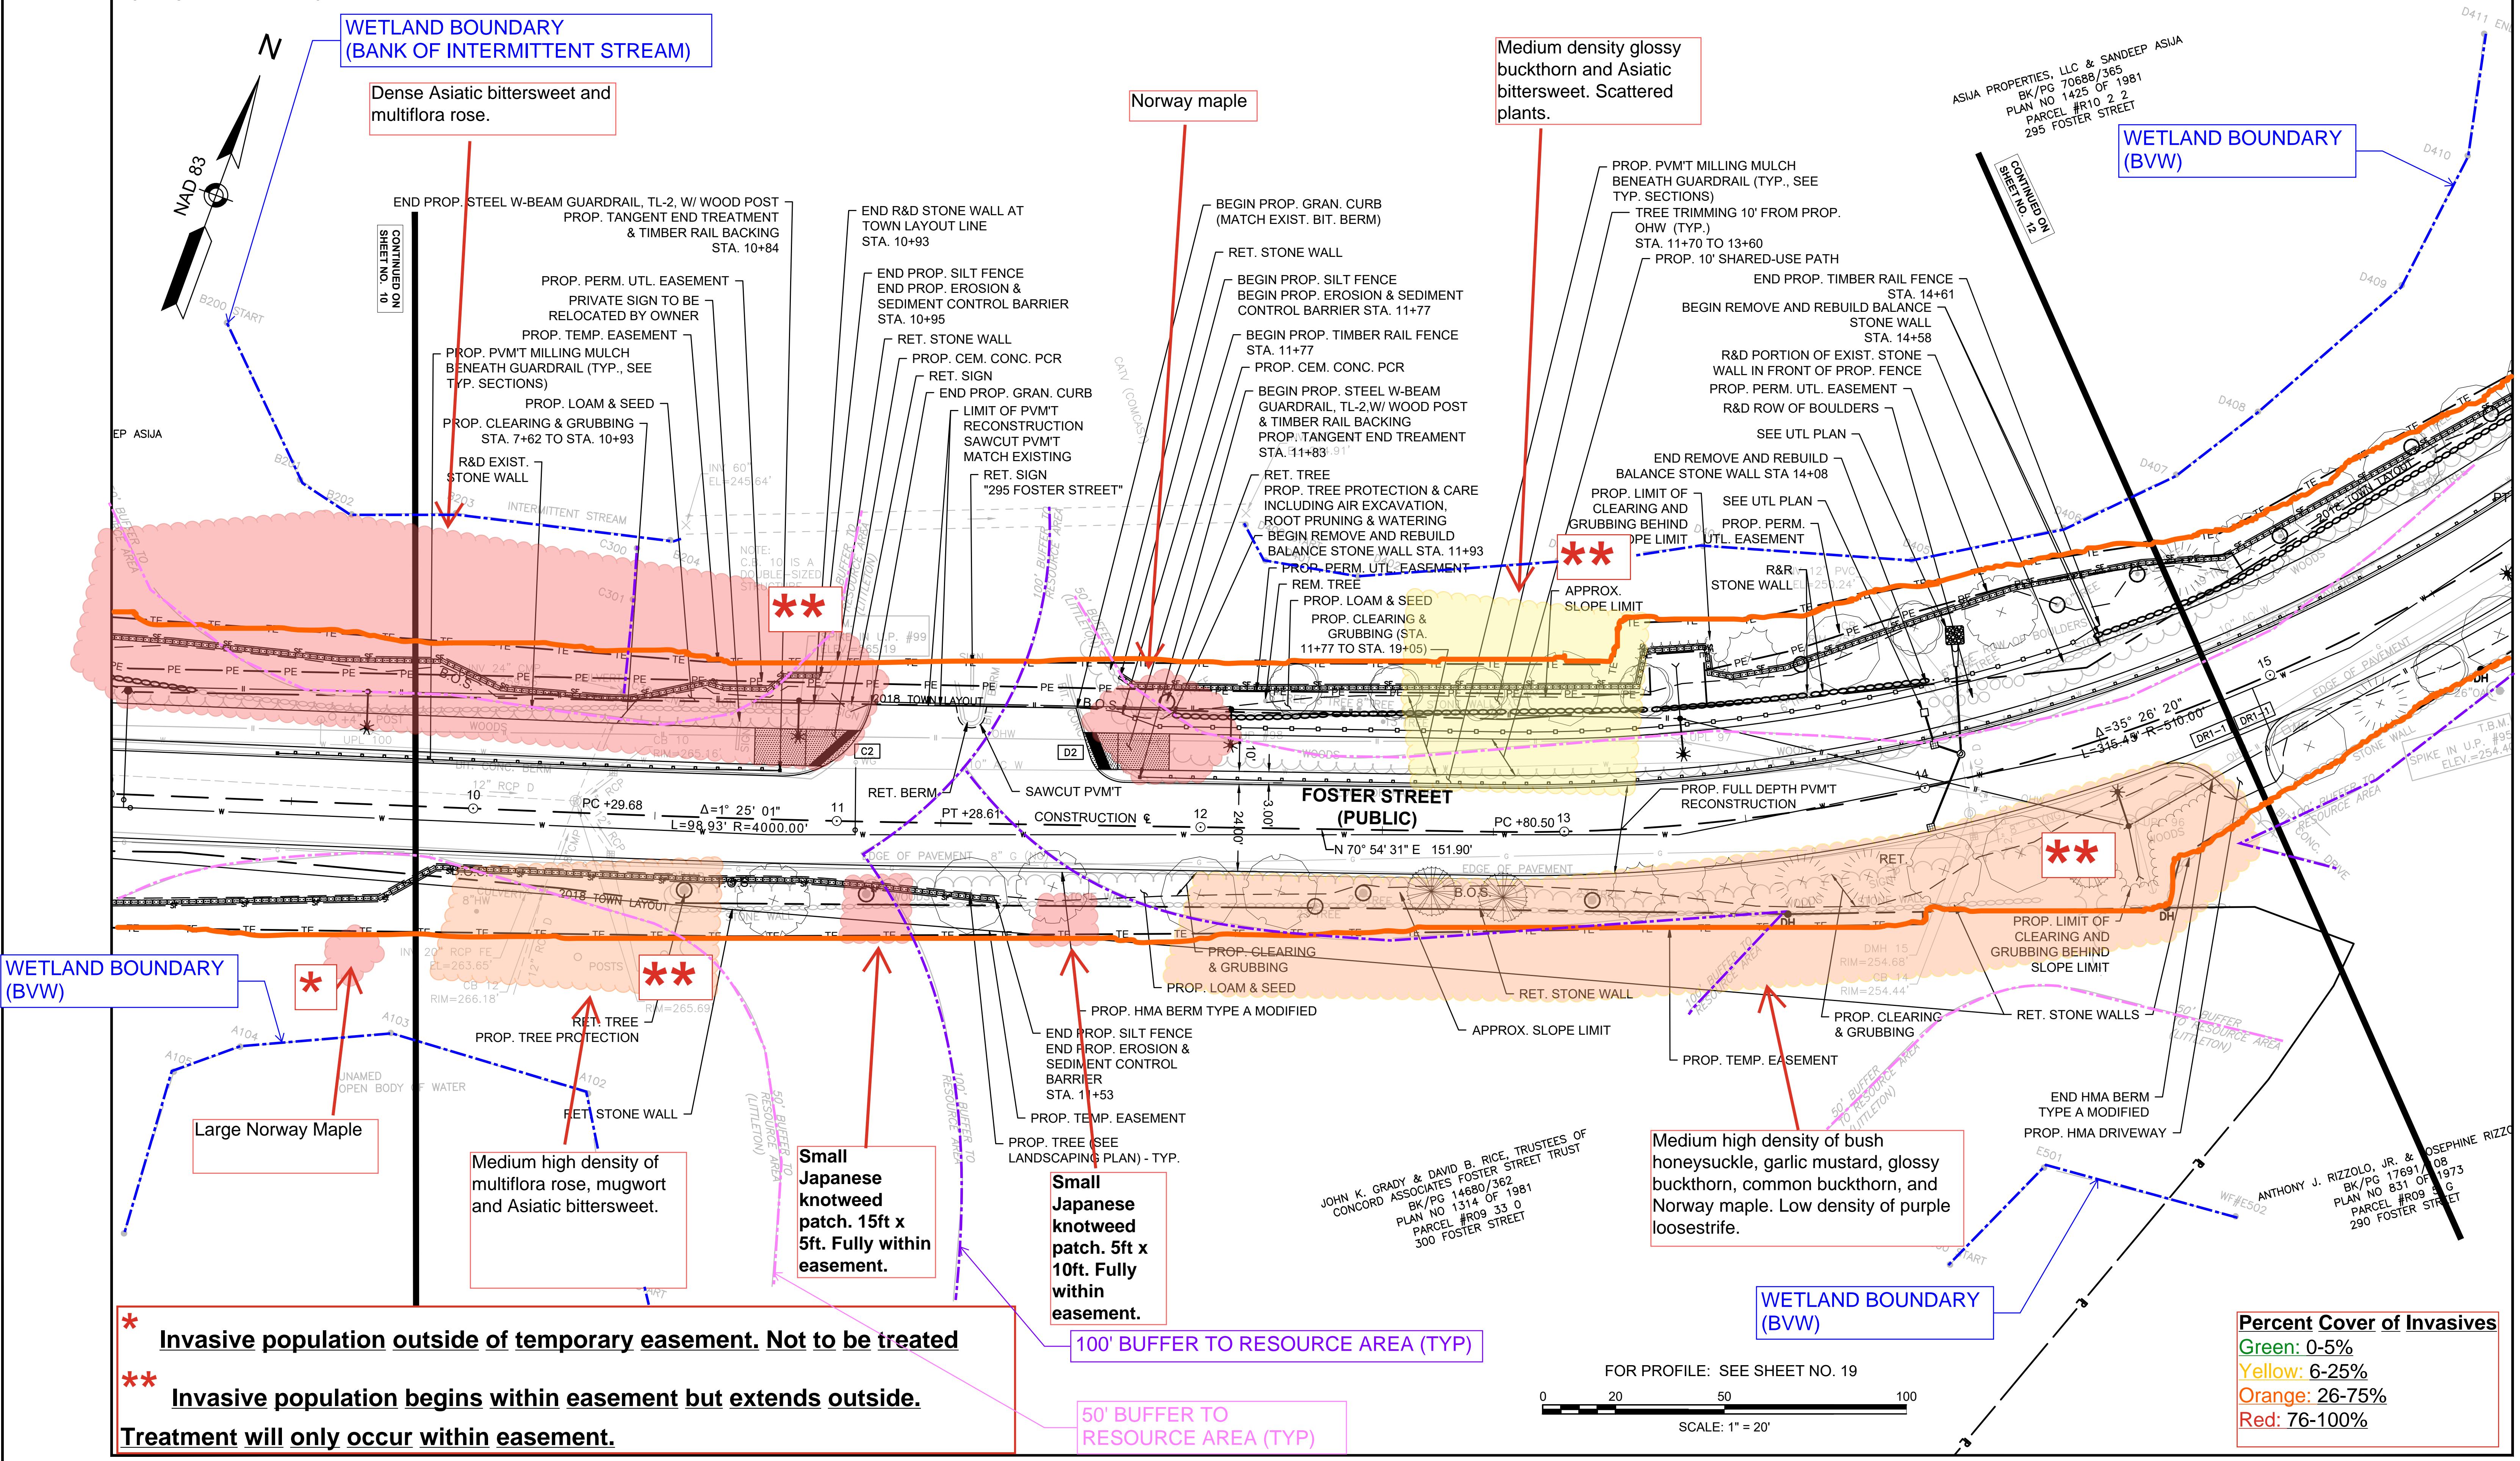PROJECT FILE NO. 609054
CONSTRUCTION PLANS

HIGHWAY GUARD DETAILS

STEEL W-BEAM GUARDRAIL (TL-2) W/ WOOD POST & TANGENT END STA. 11+94
TO TANGENT END STA 17+28

TRAFFIC SIGNAL CONDUIT

NONE

WATER SUPPLY ALTERATIONS

SEE SHEET 57-64

DRAINAGE DETAILS

SEE SHEET NOS. 65-67

LEGEND:

PROPOSED PEDESTRIAN CURB
RAMP DETAIL #

X#

PROPOSED DRIVEWAY
TYPE #


DR#

LITTLETON
RECONSTRUCTION OF FOSTER STREET

STATE	FED. AID PROJ. NO.	SHEET NO.	TOTAL SHEETS
MA	STP/CMQ/TAP-003(037)X	12	128

PROJECT FILE NO. 609054

CONSTRUCTION PLANS

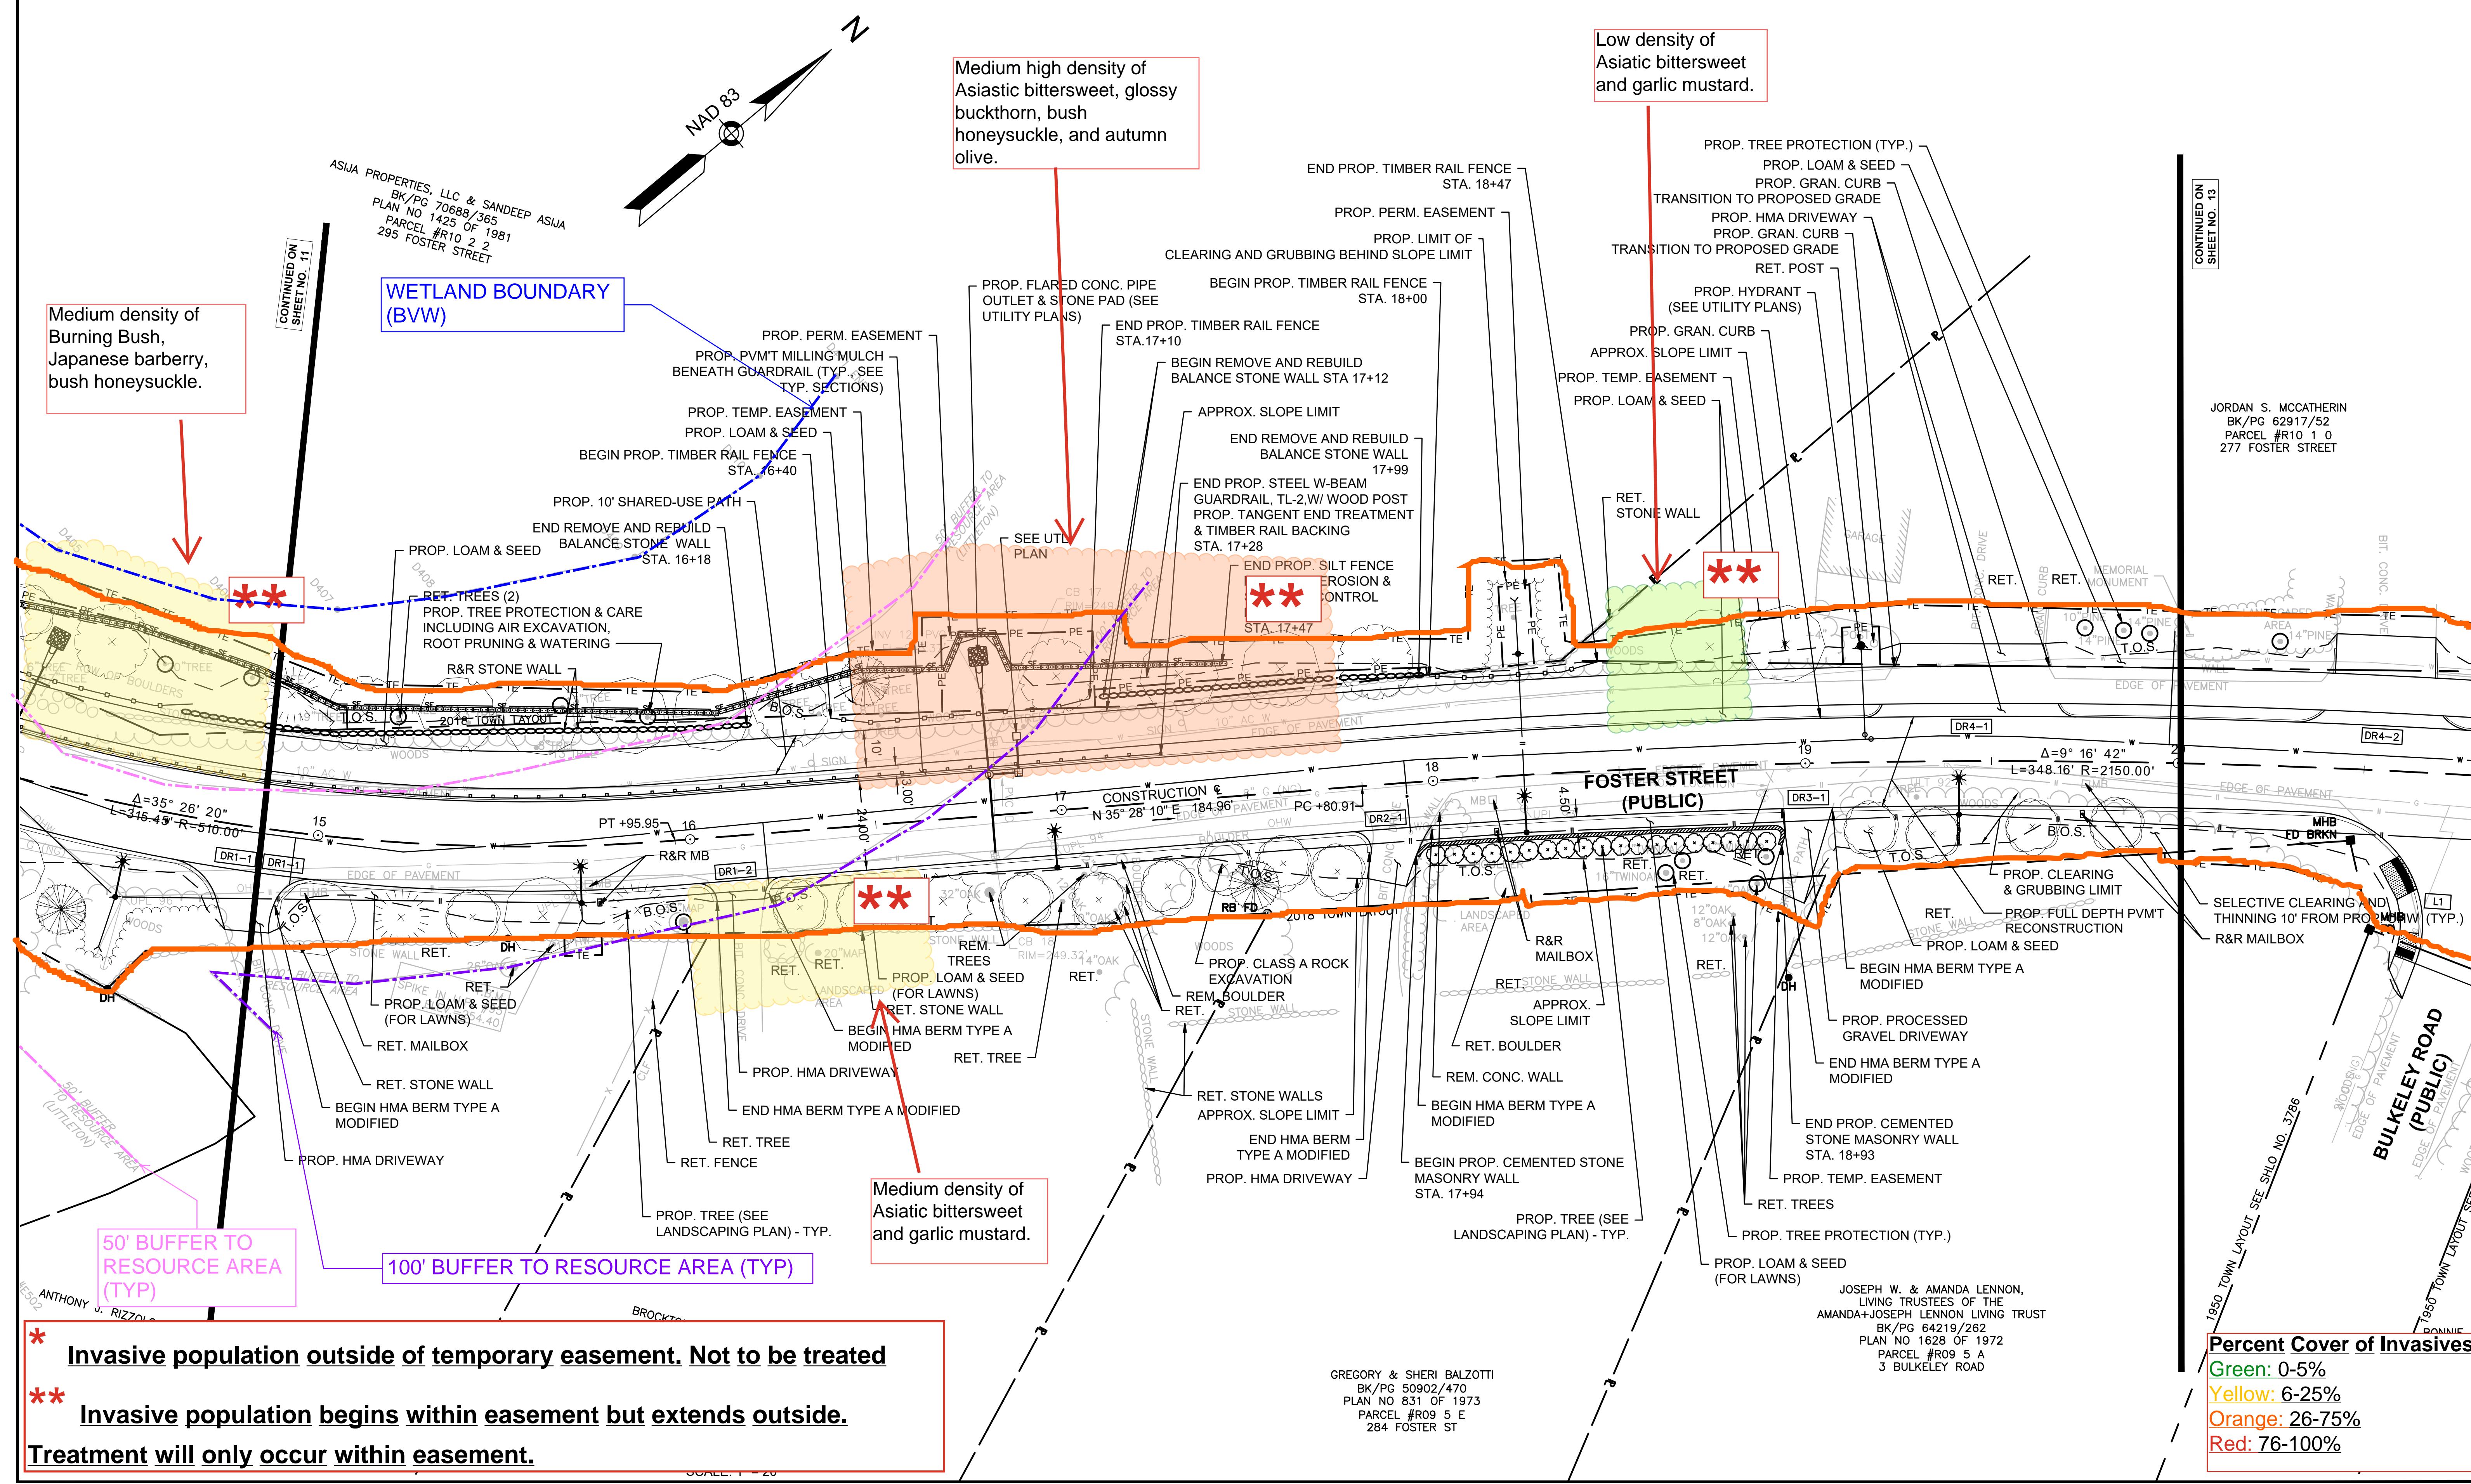Plotted on 27-Mar-2024 9:59 AM
20170044A21-HPN01.DWG

HIGHWAY GUARD DETAILS

STEEL W-BEAM GUARDRAIL (TL-2) W/ WOOD POST & TANGENT END STA. 21+22 RT TO CONCRETE ABUTMENT
STA 23+34 RT

STEEL W-BEAM GUARDRAIL (TL-2) W/ WOOD POST & TANGENT END STA. 23+26 LT TO TANGENT END STA 26+0

STEEL W-BEAM GUARDRAIL (TL-2) W/ WOOD POST & TANGENT END STA. 24+52 RT TO TANGENT END STA 25+6

WATER SUPPLY ALTERATIONS

DRAINAGE DETAILS

LEGEND:

TRAFFIC SIGNAL CONDUIT

NONI

PROPOSED D TYPE

DR#

WETLAND BOUNDARY (BANK OF INTERMITTENT STREAM)

LITTLETON
RECONSTRUCTION OF FOSTER STREET

STATE	FED. AID PROJ. NO.	SHEET NO.	TOTAL SHEETS
MA	STP/CMQ/TAP-0033(037)X	13	128
PROJECT FILE NO.		609054	

CONSTRUCTION PLANS

20170044A21_HPN01.DWG Plotted on 27-Mar-2024 9:59 AM

100' BUFFER TO RESOURCE AREA (TYP)

50' BUFFER TO RESOURCE AREA (LITTLETON)

CONTINUED ON SHEET NO. 12

CONTINUED ON SHEET NO. 14

CONTINUED ON SHEET NO. 14

Low density of mugwort and Asiatic bittersweet.

Medium high density of mugwort, Asiatic bittersweet, common buckthorn and Japanese barberry.

Medium high density of Asiatic bittersweet and burning bush. There are a few feet of mowed grass in front of the patch and may not be impacted by construction.

Medium high density of mugwort, Asiatic bittersweet, common buckthorn and Japanese barberry.

* Invasive population outside of temporary easement. Not to be treated.

** Invasive population begins within easement but extends outside.

Treatment will only occur within easement.

Medium high density of Asiatic bittersweet, mugwort, common buckthorn and Japanese barberry.

FOR PROFILE E: SEE SHEET NO. 21

SCALE: 1" = 20'

R&S METAL FENCE
(CUT OFF AT NEAREST POST
BEHIND SLOPE LIMIT)

Medium high density of mugwort, Asiatic bittersweet, common buckthorn and autumn olive

Percent Cover of Invasives

Green: 0-5%

Yellow: 6-25%

Orange: 26-75%

Red: 76-100%

* Invasive population outside of temporary easement. Not to be treated

** Invasive population begins within easement but extends outside.

Treatment will only occur within easement.

WATER SUPPLY ALTERATIONS DRAINAGE DETAILS

LEGEND:

RAMP DETAIL

PROPOSED DRIVEWAY

LITTLETON


RECONSTRUCTION OF FOSTER STREET

STATE	FED. AID PROJ. NO.	SHEET NO.	TOTAL SHEET
MA	STP/CMQ/TAP-0033(037)X	14	128
PROJECT FILE NO.		609054	

CONSTRUCTION PLANS

CHUSETTS BAY TRANSIT
(PARCEL FBL 3-B)
BK/PG 57072/384
BK/PG 57072/376
PLAN NO 435 OF 20
PARCEL #R11 3 5
263 FOSTER STREET

Plotted on 27-Mar-2024 9:59 AM

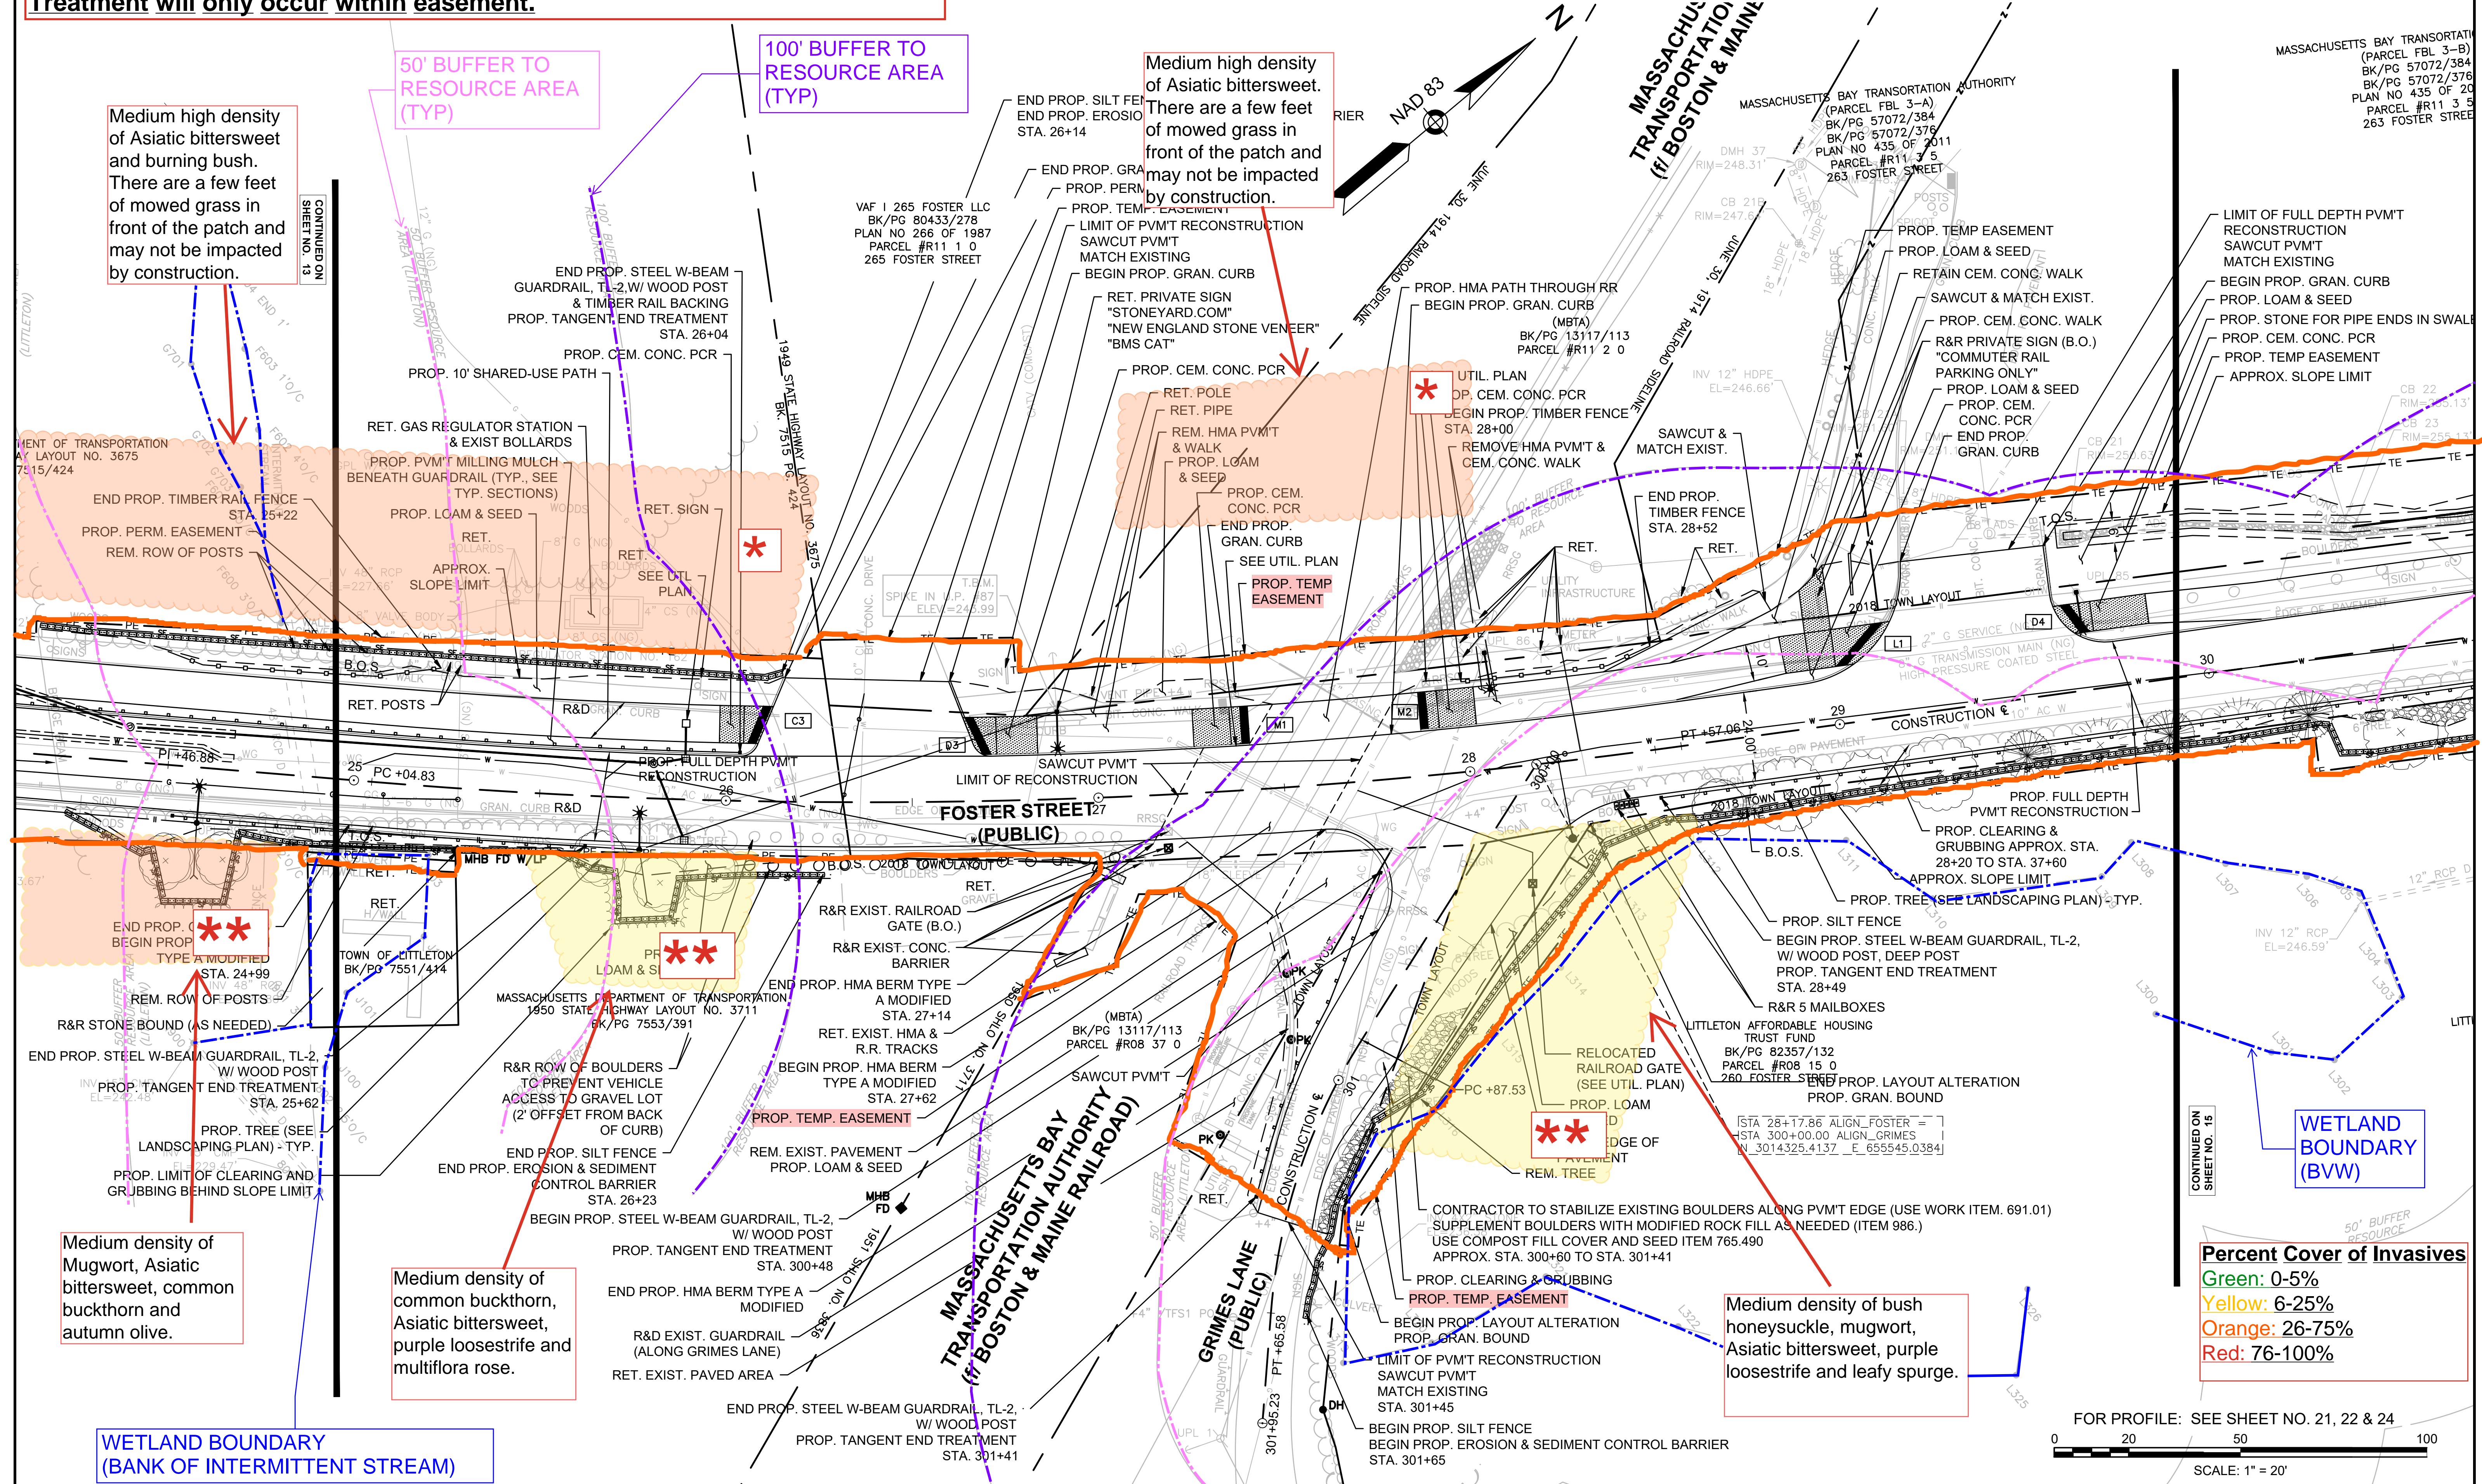

* Invasive population outside of temporary easement. Not to be treated
 ** Invasive population begins within easement but extends outside.
 Treatment will only occur within easement.

WATER SUPPLY ALTERATIONS SEE SHEET 57-64

DRAINAGE DETAILS SEE SHEET NOS. 65-67

LEGEND:

PROPOSED PEDESTRIAN CURB RAMP DETAIL # X#

TRAFFIC SIGNAL CONDUIT NONE

PROPOSED DRIVEWAY TYPE # DR#


LITTLETON
 RECONSTRUCTION OF FOSTER STREET

STATE	FED. AID PROJ. NO.	HEET NO.	TOTAL SHEETS
MA	STP/CMQ/TAP-003(037)X	15	128

PROJECT FILE NO. 609054

CONSTRUCTION PLANS

Plotted on 27-Mar-2024 9:59 AM
 20170044A21-HPN01.DWG

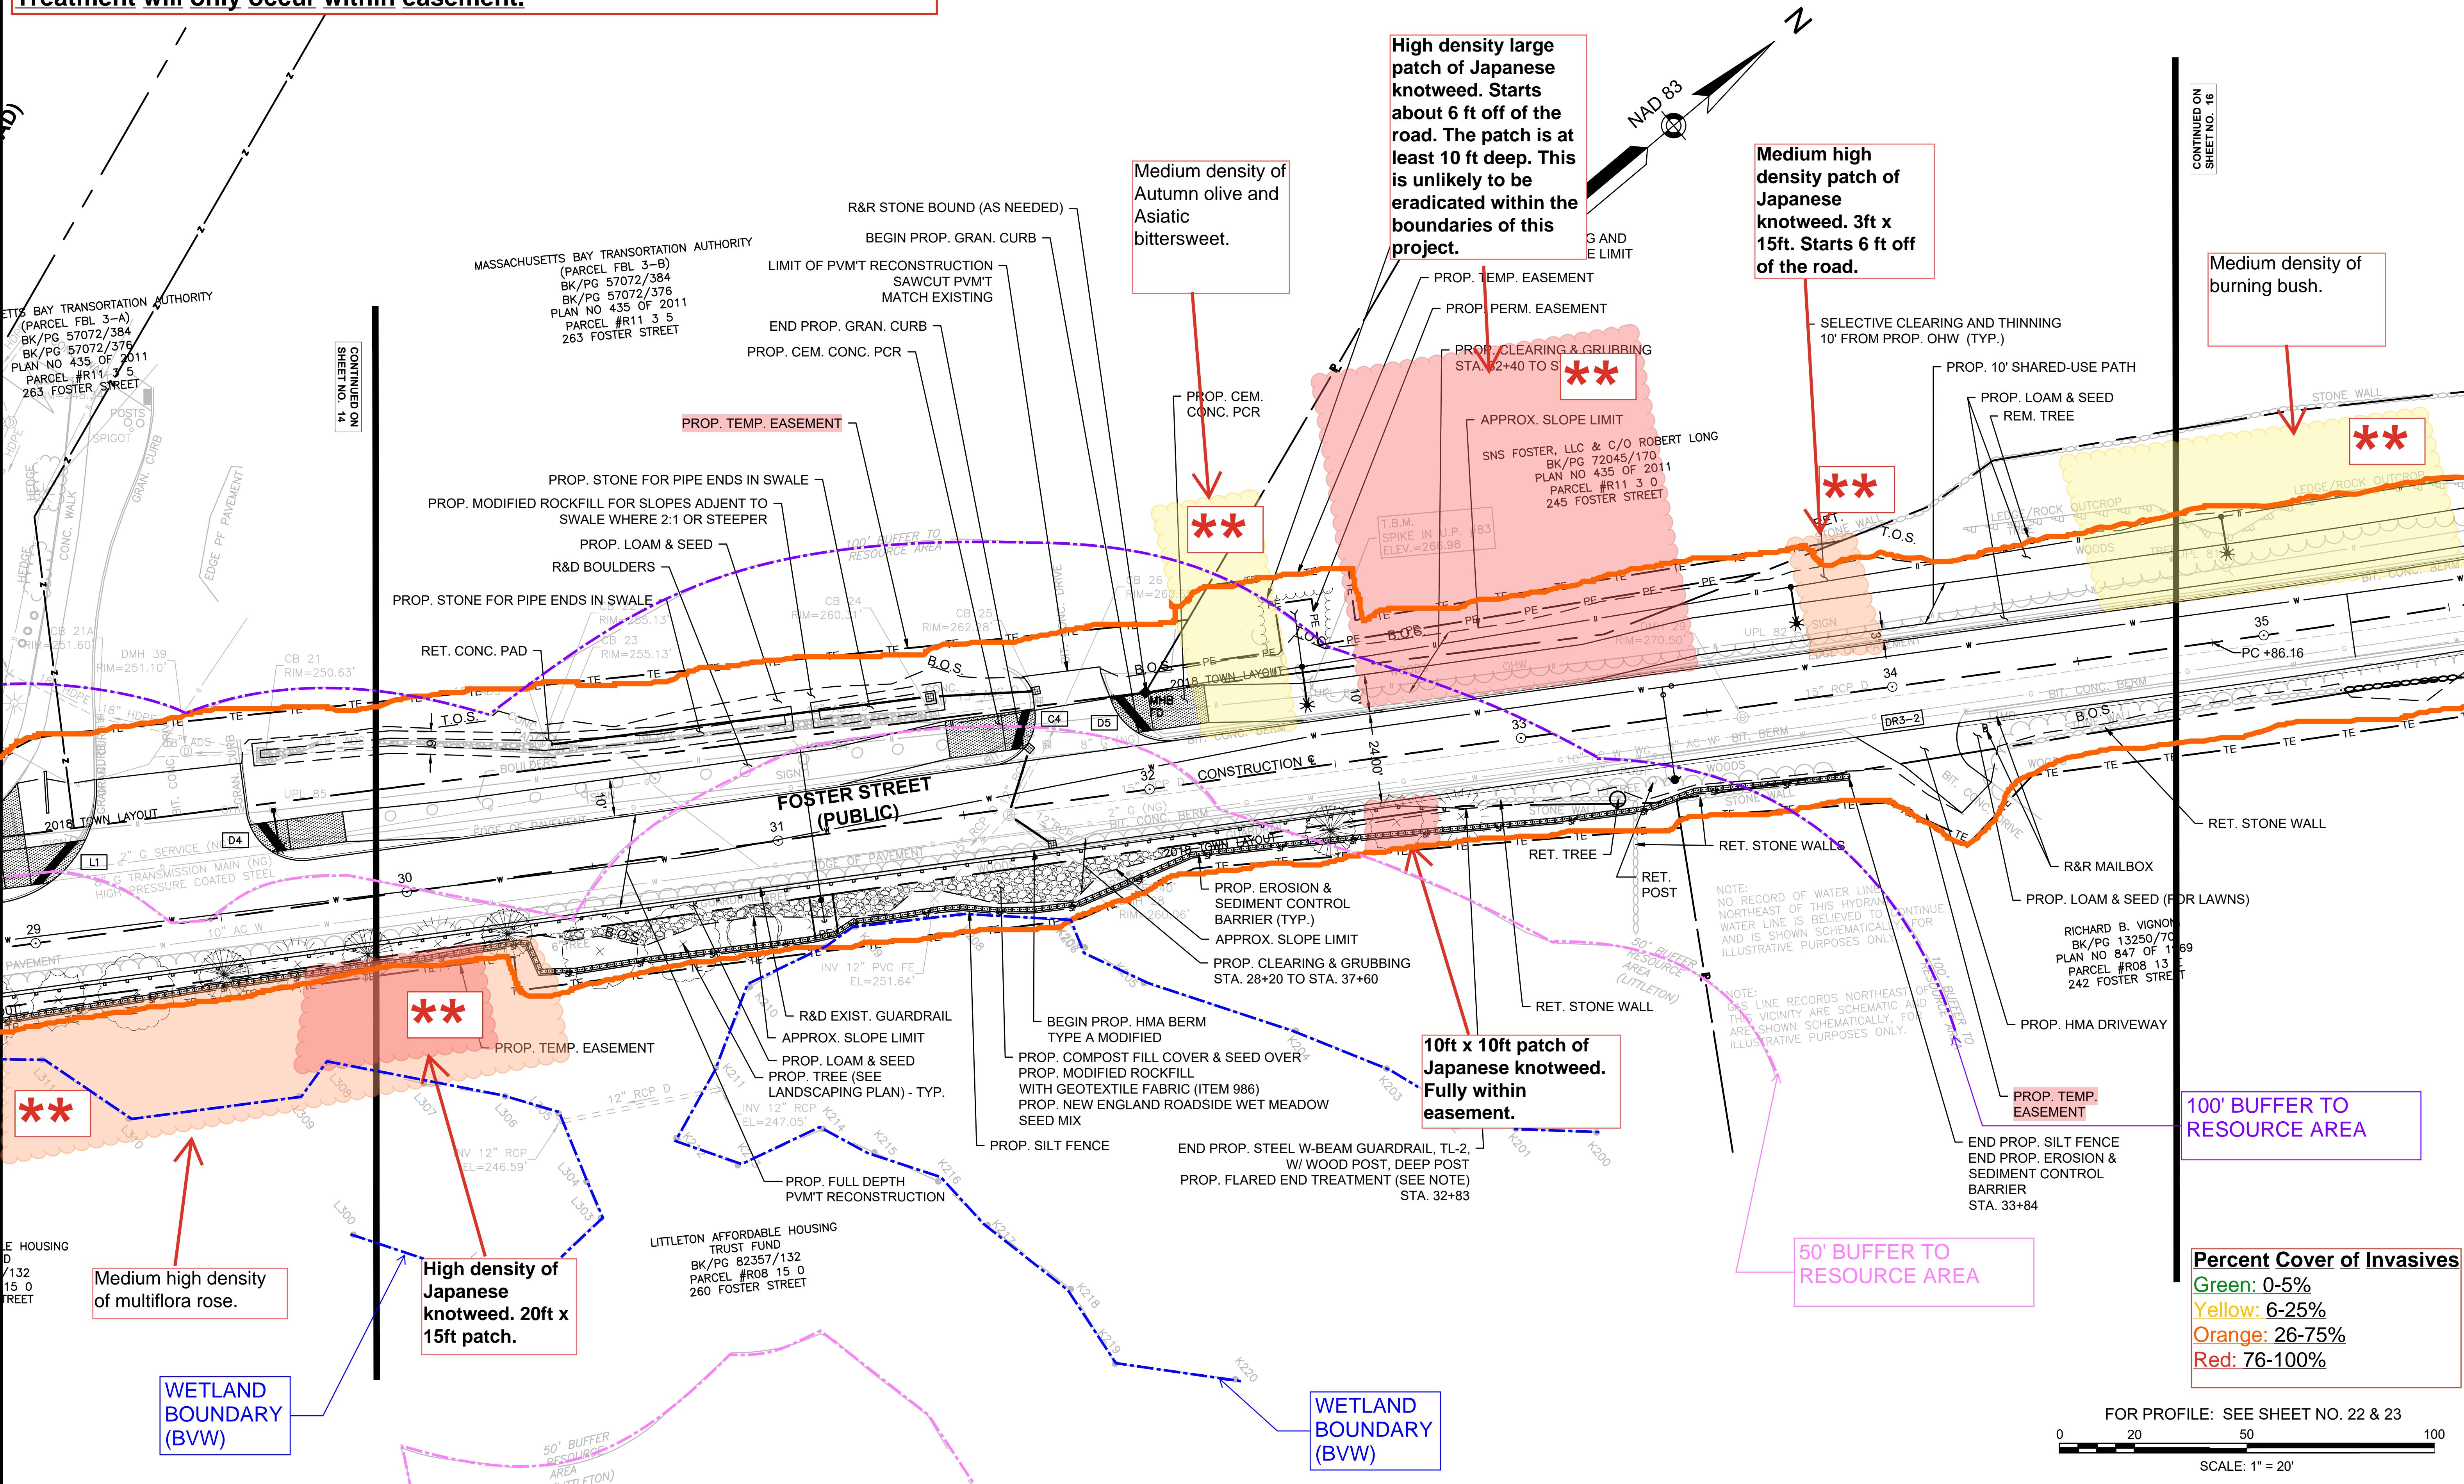

* Invasive population outside of temporary easement. Not to be treated

** Invasive population begins within easement but extends outside.

Treatment will only occur within easement.

WATER SUPPLY ALTERATIONS

SEE SHEET 57-64

DRAINAGE DETAILS

SEE SHEET NOS. 65-67

LEGEND:

PROPOSED PEDESTRIAN CURB RAMP DETAIL # X#

PROPOSED DRIVEWAY TYPE # DR#

LITTLETON
RECONSTRUCTION OF FOSTER STREET

STATE	FED. AID PROJ. NO.	SHEET NO.	TOTAL SHEETS
MA	STP/CMQ/TAP-0033(037)X	16	128
PROJECT FILE NO. 609054			

CONSTRUCTION PLANS

Plotted on 27-Mar-2024 9:59 AM
20170044A21-HPN01.DWG

PATRICIA A. NARGIZIAN
BK/PG 70735/467
PARCEL #R11 5 4
237 FOSTER STREET

SHEET NO. 16

Invasive Stockpile Location

Low density of burning bush, garlic mustard, glossy buckthorn, common buckthorn, and Asiatic bittersweet.

PROP. LIMIT OF CLEARING AND GRUBBING BEHIND SLOPE LIMIT
PROP. CLASS A ROCK EXCAVATION IN ADVANCE OF U.P. INSTALLATION (AS ENCOUNTERED)
SNS FOSTER, LLC & C/O ROBERT LONG
BK/PG 72045/170
PLAN NO 435 OF 2011
PARCEL #R11 3 0
245 FOSTER STREET

PROP. LOAM & SEED
SELECTIVE CLEARING AND THINNING 10' FROM PROP. OHW (TYP.)
NOTE: C.B. 32 IS A DOUBLE-SIZE STRUCTURE.
PROP. 10' SHARED-USE PATH
APPROX. SLOPE LIMIT
TOS
STONE WALL
PROP. FULL DEPTH PVM'T RECONSTRUCTION
PVM'T RECONSTRUCTION
T.O.S.

LEDDGE/ROCK OUTCROP
TOS
B.O.S.
STONE WALL
PROP. CLASS A ROCK EXCAVATION IN ADVANCE OF U.P. INSTALLATION (AS ENCOUNTERED)
CONSTRUCTION
PC +86.16
35
PC +06.15
L=204.20 R=2974.57
36
37
5510
5511
55100
55101
55200
55201
5549

APPENDIX B

Photographs

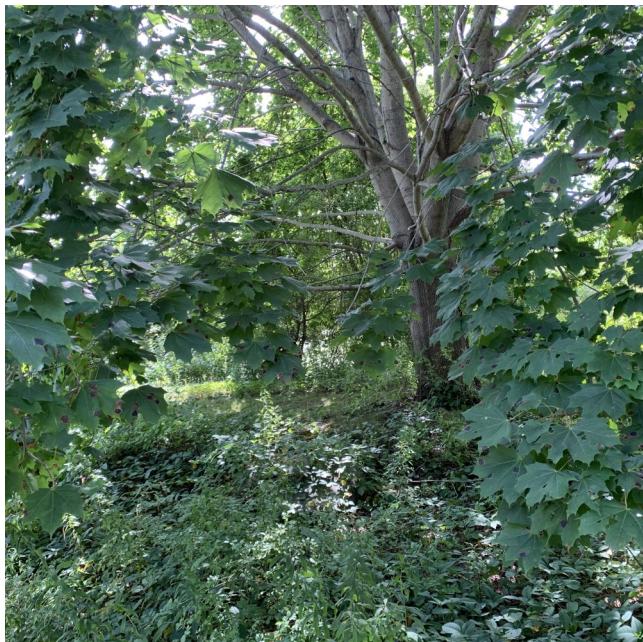


Photo Number: 1

Direction: SE

Photographer: Adriana Hughes

Date: 8.30.24

Comments: Large Norway Maple

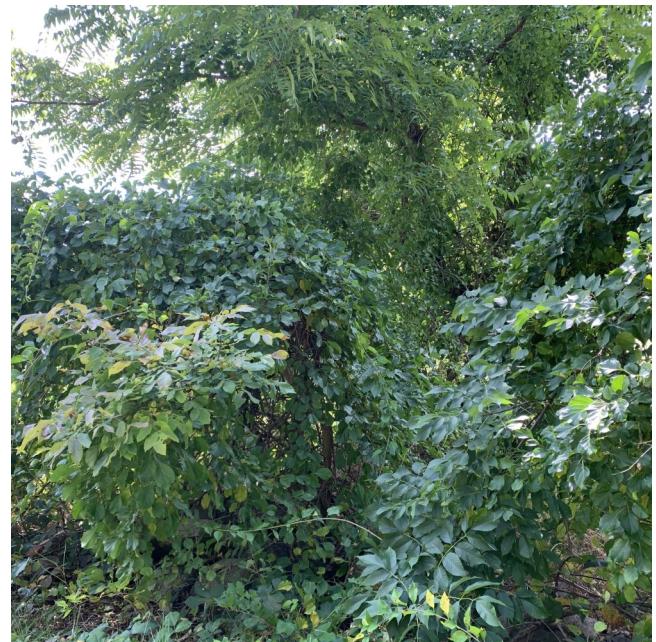


Photo Number: 2

Direction: SE

Photographer: Adriana Hughes

Date: 8.30.24

Comments: Climbing Asiatic bittersweet.



Photo Number: 3

Direction: Down

Photographer: Adriana Hughes

Date: 8.30.24

Comments: Small patch of Japanese knotweed near STA 5 + 50

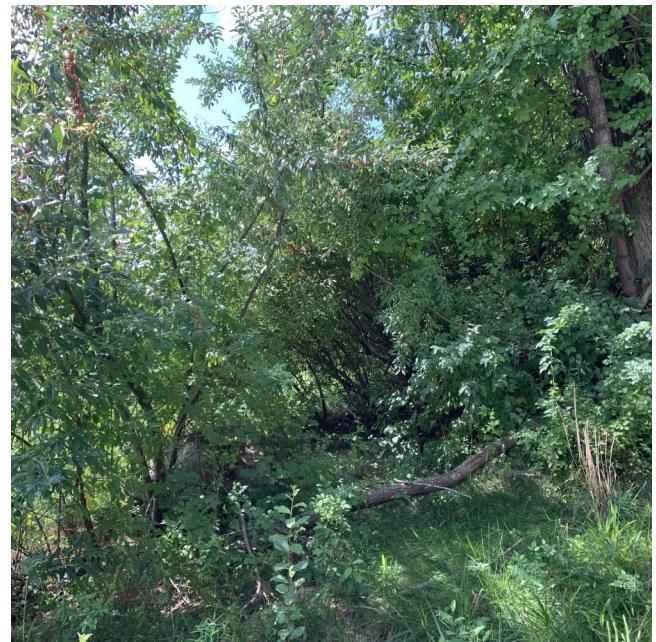


Photo Number: 4

Direction: SE

Photographer: Adriana Hughes

Date: 8.30.24

Comments: Medium density of multiflora rose, Asiatic bittersweet and autumn olive.



Photo Number: 5

Direction: SW

Photographer: Adriana Hughes

Date: 8.30.24

Comments: Large autumn olive shrub.



Photo Number: 6

Direction: SW

Photographer: Adriana Hughes

Date: 8.30.24

Comments: Large Japanese knotweed patch growing along Taylor Street.



Photo Number: 7

Direction: W

Photographer: Adriana Hughes

Date: 8.30.24

Comments: Large Japanese knotweed patch growing along Taylor Street.



Photo Number: 8

Direction: NW

Photographer: Adriana Hughes

Date: 8.30.24

Comments: Low density of Asiatic bittersweet and garlic mustard by STA 6.



Photo Number: 9

Direction: NW

Photographer: Adriana Hughes

Date: 8.30.24

Comments: High density of Asiatic bittersweet and buckthorn by STA 6 +15.



Photo Number: 10

Direction: NW

Photographer: Adriana Hughes

Date: 8.30.24

Comments: High density of climbing Asiatic bittersweet by STA 6 + 25.



Photo Number: 11

Direction: NW

Photographer: Adriana Hughes

Date: 8.30.24

Comments: High density of Asiatic bittersweet extending past the project boundaries by STA 7.



Photo Number: 12

Direction: NW

Photographer: Adriana Hughes

Date: 8.30.24

Comments: High density of climbing Asiatic bittersweet and porcelain berry between STA 7 and 8.



Photo Number: 13

Direction: NW

Photographer: Adriana Hughes

Date: 8.30.24

Comments: Close up of porcelain berry.



Photo Number: 14

Direction: NW

Photographer: Adriana Hughes

Date: 8.30.24

Comments: Close up of porcelain berry and multiflora rose.



Photo Number: 15

Direction: W

Photographer: Adriana Hughes

Date: 8.30.24

Comments: High density climbing Asiatic bittersweet.



Photo Number: 16

Direction: NW

Photographer: Adriana Hughes

Date: 8.30.24

Comments: Medium high density climbing Asiatic bittersweet.

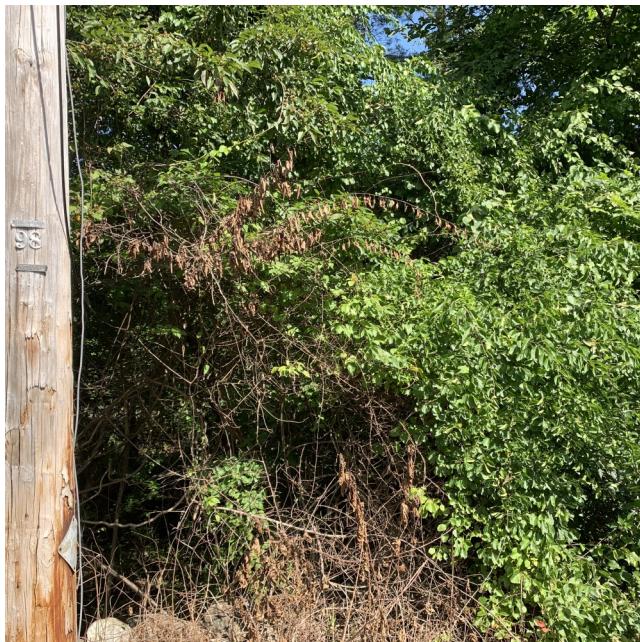


Photo Number: 17

Direction: NW

Photographer: Adriana Hughes

Date: 8.30.24

Comments: High density climbing Asiatic bittersweet.



Photo Number: 18

Direction: NW

Photographer: Adriana Hughes

Date: 8.30.24

Comments: Medium density Asiatic bittersweet and glossy buckthorn.



Photo Number: 19

Direction: NW

Photographer: Adriana Hughes

Date: 8.30.24

Comments: Medium density burning bush near STA 24 + 50.



Photo Number: 20

Direction: NW

Photographer: Adriana Hughes

Date: 8.30.24

Comments: High density Japanese knotweed patch near STA 33.



Photo Number: 21

Direction: NW

Photographer: Adriana Hughes

Date: 8.30.24

Comments: Medium density Japanese knotweed near STA 34.



Photo Number: 22

Direction: NW

Photographer: Adriana Hughes

Date: 8.30.24

Comments: Medium density of glossy buckthorn and multiflora rose near STA 38.



Photo Number: 23

Direction: SE

Photographer: Adriana Hughes

Date: 8.30.24

Comments: Medium density Japanese knotweed near STA 36.



Photo Number: 24

Direction: SE

Photographer: Adriana Hughes

Date: 8.30.24

Comments: Medium density Japanese knotweed near STA 36.



Photo Number: 25

Direction: NW

Photographer: Adriana Hughes

Date: 8.30.24

Comments: Medium density garlic mustard, glossy buckthorn and bush honeysuckle near STA 38.

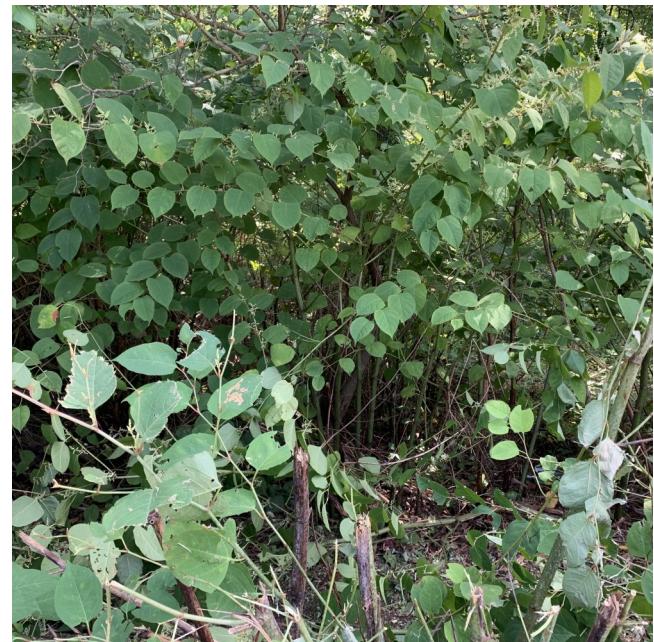


Photo Number: 26

Direction: W

Photographer: Adriana Hughes

Date: 8.30.24

Comments: High density Japanese knotweed patch.

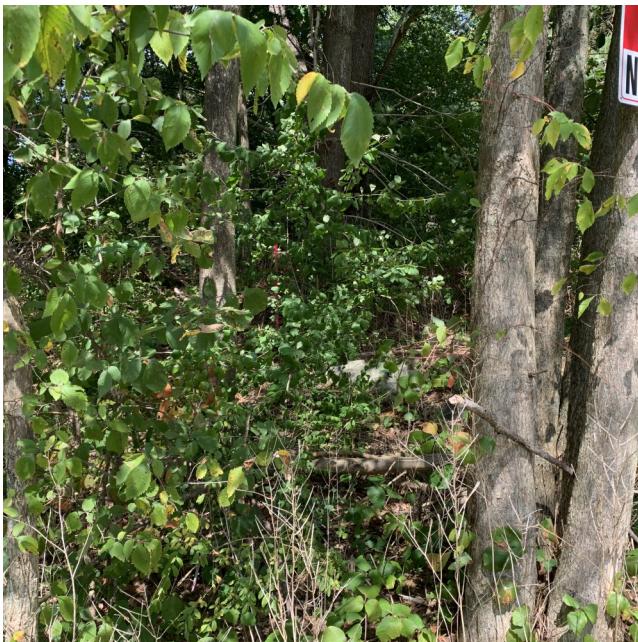


Photo Number: 27

Direction: NW

Photographer: Adriana Hughes

Date: 8.30.24

Comments: Medium density garlic mustard, glossy buckthorn and bush honeysuckle extending outside the project boundaries near STA 38.

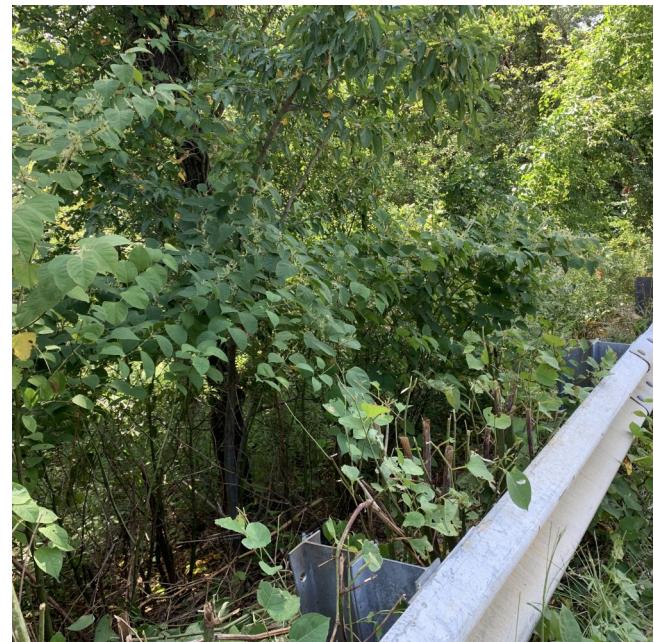


Photo Number: 28

Direction: SE

Photographer: Adriana Hughes

Date: 8.30.24

Comments: High density Japanese knotweed patch near STA 32 + 50.

APPENDIX C

MassDOT Herbicide Use Report Form

MassDOT Herbicide Use Report

Date Submitted:

Use multiple sheets for multiple application techniques or sites as needed.

Contractor Performing Work:	<input type="text"/>	Project or Contract No:	<input type="text"/>
Town/s:	<input type="text"/>	Associated Route:	<input type="text"/>
Project Description:	<input type="text"/>		
Treatment Description:	Area Treated (as applicable) Acres: <input type="text"/> Sq Yds: <input type="text"/> Miles: <input type="text"/>		
Weeds Targeted:	Gallons Formula Used: <input type="text"/> Date/Time Began: <input type="text"/> Date/Time End: <input type="text"/>		
Application Method:			

Product Used:

Name: <input type="text"/>	Name: <input type="text"/>	Name: <input type="text"/>
EPA Reg. No: <input type="text"/>	EPA Reg. No: <input type="text"/>	EPA Reg. No: <input type="text"/>
% Active Ingredient	% Active Ingredient	% Active Ingredient
Dry: <input type="text"/>	Dry: <input type="text"/>	Dry: <input type="text"/>
Liquid: <input type="text"/>	Liquid: <input type="text"/>	Liquid: <input type="text"/>
Formulation (dilution rate): <input type="text"/>	Formulation (dilution rate): <input type="text"/>	Formulation (dilution rate): <input type="text"/>

Additional products used (surfactants, etc.) or other information:

<input type="text"/>

Applicators: 	License Numbers:
-----------------------------------------	---------------------------------------------

Upon completion, please submit form to MassDOT District Engineer and Landscape Design Section in Boston office.

11-16-2017